

STATE OF KANSAS
STATE CORPORATION COMMISSION

Give Information Completely
Make Required Affidavit
Mail or Deliver Report to:
Conservation Division
State Corporation Commission
800 Bittling Building
Wichita, Kansas


WELL PLUGGING RECORD

OR

FORMATION PLUGGING RECORD

Strike out upper line
when reporting plug-
ging off formations.

NORTH

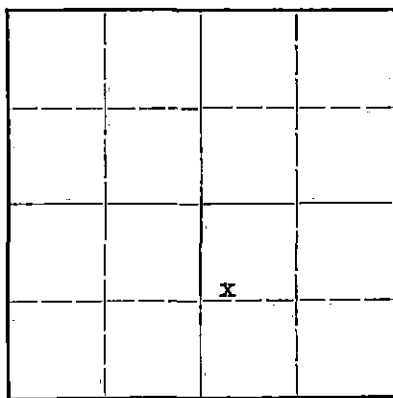

Locate well correctly on above
Section Plat

Stafford County. Sec. 13 Twp. 24 Rge. II (E) W. (W)
Location as "NE $\frac{1}{4}$ NW $\frac{1}{4}$ SW $\frac{1}{4}$ " or footage from lines. SW Nw - SE
Lease Owner. MABEE OIL & GAS CO.
Lease Name. Cleo Johnson Well No. 3
Office Address. Box # 28 Zenith, Kansas
Character of Well (completed as Oil, Gas or Dry Hole). Oil & Gas
Date well completed. Nov. 23. 19 38
Application for plugging filed. Oct. 15. 19 45
Application for plugging approved. Oct. 17. 19 45
Plugging commenced. Oct. 30. 19 45
Plugging completed. Nov. 3. 19 45
Reason for abandonment of well or producing formation. Oil exhausted

If a producing well is abandoned, date of last production. Oct. 15. 19 45
Was permission obtained from the Conservation Division or its agents before plugging was com-
menced? Yes

Name of Conservation Agent who supervised plugging of this well. H.W. Kerr
Producing formation. Viola Lime Depth to top. 3.795 Bottom. 3.809 Total Depth of Well. 3.809 Feet
Show depth and thickness of all water, oil and gas formations.


OIL, GAS OR WATER RECORDS

CASING RECORD

Formation	Content	From	To	Size	Put In	Pulled Out
Lansing Lime		3.395	3.430			
Misener	Oil & Gas	3.789	3.795			
Viola Lime	Oil & Gas	3.795	3.809	7" O.D.	3.781	2.756

Describe in detail the manner in which the well was plugged, indicating where the mud fluid was placed and the method or methods used in introducing it into the hold. If cement or other plugs were used, state the character of same and depth placed, from _____ feet to _____ feet for each plug set.

9 Sacks cement from 3.809 to 3.775
filled hole with heavy mud from 3.775 to 260'
Set rock bridge 260' to 250'
15 sacks cement from 250' to 240'
Filled hole with mud from 240' to 15'
10 Sacks cement from 15' to cellar base for cap.

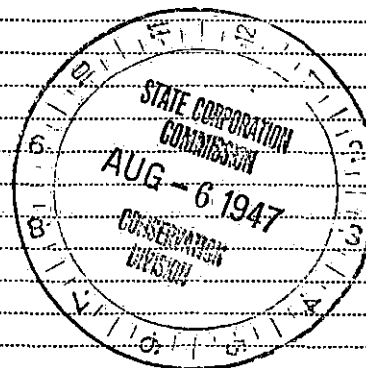

(If additional description is necessary, use BACK of this sheet)

Correspondence regarding this well should be addressed to. MABEE OIL & GAS CO.
Address. Box # 28 Zenith, Kansas

STATE OF Kansas, COUNTY OF Stafford, ss.
H.A. Marks (employee of owner) or (owner or operator) of the above-described well,
being first duly sworn on oath, says: That I have knowledge of the facts, statements, and matters herein contained and the log of the above-
described well as filed and that the same are true and correct. So help me God.

(Signature)

H.A. Marks

Box 28 Zenith, Kansas

SUBSCRIBED AND SWORN to before me this Aug 6, 1947 day of

My commission expires April 6, 1951

Notary Public.

20-1300-S 11-43-10M

