


STATE OF KANSAS  
STATE CORPORATION COMMISSION

15.167.3015400.00  
WELL PLUGGING RECORD

Give All Information Completely  
Mail Required Affidavit  
Mail or Deliver Report to:  
Conservation Division  
State Corporation Commission  
211 No. Broadway  
Wichita, Kansas

NORTH

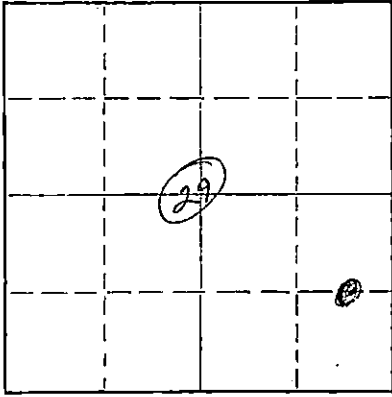

Locate well correctly on above  
Section Plat

Russell County. Sec. 29 Twp. 15s Rge. 11 (E) W (W)  
Location as "NE/CNW/SW" or footage from lines C-~~2~~-~~E~~-~~SE~~  
Lease Owner S. and C. Drlg, Inc.  
Lease Name Carrie Chegwidde Well No. 3  
Office Address Box 271 Hays, Kansas  
Character of Well (completed as Oil, Gas or Dry Hole) D & A  
Date well completed 10-2 19 65  
Application for plugging filed 10-2 19 65  
Application for plugging approved 10-2 19 65  
Plugging commenced 10-2 19 65  
Plugging completed 10-2 19 65  
Reason for abandonment of well or producing formation No oil shows

If a producing well is abandoned, date of last production \_\_\_\_\_ 19\_\_\_\_  
Was permission obtained from the Conservation Division or its agents before plugging was commenced? Yes

Name of Conservation Agent who supervised plugging of this well Eldon Petty  
Producing formation \_\_\_\_\_ Depth to top \_\_\_\_\_ Bottom \_\_\_\_\_ Total Depth of Well 3265 Feet  
Show depth and thickness of all water, oil and gas formations.

OIL, GAS OR WATER RECORDS

Surface CASING RECORD

FORMATION	CONTENT	FROM	TO	SIZE	PUT IN	PULLED OUT
Surface clay & sand		0	50	8-5/8"		
Shale & shells		50	192			
Shale		192	269			
Cemented w/165 sks HA5						

Describe in detail the manner in which the well was plugged, indicating where the mud fluid was placed and the method or methods used in introducing it into the hole. If cement or other plugs were used, state the character of same and depth placed, from 3265 feet to 260 feet for each plug set.

Filled w/heavy mud to 260'. Set plug @260'. 1/2 sk hulls mixed & poured through drill pipe. 25 sks cement & filled to 40' plug 1/2 sk hulls 10 sks cement. Through plugging @ 5:30 a.m.

RECEIVED  
STATE CORPORATION COMMISSION

NOV 1 1965

CONSERVATION DIVISION  
Wichita, Kansas

(If additional description is necessary, use BACK of this sheet)

Name of Plugging Contractor S. and C. Drlg, Inc.  
Address Box 271 Hays, Kansas

STATE OF Kansas COUNTY OF Ellis, ss.  
Dallas J. Sullivan (employee of owner) or (owner or operator) of the above-described well, being first duly sworn on oath, says: That I have knowledge of the facts, statements, and matters herein contained and the log of the above-described well as filed and that the same are true and correct. So help me God.

(Signature) Dallas J. Sullivan

(Address)

SUBSCRIBED AND SWORN to before me this 29th day of October, 19 65

Laurence J. Brown Notary Public.

My commission expires 6-13-66

C. R. CARLSON  
President

D. J. SULLIVAN  
Vice-President  
and General Manager

15.167.30154.00.001

# S. and C. Drilling, Inc.

Phone MA 4-4350 - Box 271

HAYS, KANSAS



## CERTIFIED DRILLER'S LOG

COMPANY: S. and C. Drilling, Inc.

LEASE: Chegwidden

CONTRACTOR: S. and C. Drlg, Inc.

LOCATION: C-E $\frac{1}{2}$ -E $\frac{1}{2}$ -SE $\frac{1}{2}$   
29-15s-11W

Russell Co., Kansas

Commenced under surface: 9-25-65

COMPLETED: 10-2-65

ELEVATION: ~~XXXX~~ 1749 K.B.

POTENTIAL: D & A

FIGURES DENOTE BOTTOM OF FORMATION: K.B. MEASUREMENTS.  
(gr. level, plus 5')

<u>FORMATION</u>	<u>DEPTH</u>
Shale	255
Shale & shells	611
Anhydrite	638
Red bed & Shale	840
Shale	1510
Shale & Lime	1675
Lime & Shale	2775
Lime w/shale streaks	2880
Lime & Shale	2990
Lime	3186
Conglomerate	3237
Arbuckle	3265


RECEIVED  
STATE CORPORATION COMMISSION

NOV 1 1965

CONSERVATION DIVISION  
Wichita, Kansas

I hereby certify that this is a true and correct copy of the above log to the best of my knowledge.

S. and C. Drilling, Inc.

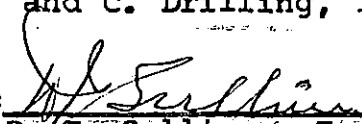By:   
D. J. Sullivan, Exec. Vice Pres