


15. 167. 00169. 00. 00

WELL PLUGGING RECORD

Give All Information Completely
Make Required Affidavit
Mail or Deliver Report to:
Conservation Division
State Corporation Commission
800 Bittling Building
Wichita, Kansas

Russell County. Sec. 13 Twp. 15 Rge. 11 (E) (W)
Location as "NE/CNW/4SW/4" or footage from lines SW, SW, SW
Lease Owner Continental Oil Co.
Lease Name V. Hoch Well No. 1
Office Address Drawer 1267 Ponca City, Okla. Geol. Dept.
Character of Well (completed as Oil, Gas or Dry Hole) Dry
Date well completed 1-28-51 19
Application for plugging filed 1-31-51 19
Application for plugging approved 1-31-51 19
Plugging commenced 2-2-51 19
Plugging completed 2-2-51 19
Reason for abandonment of well or producing formation dry

NORTH

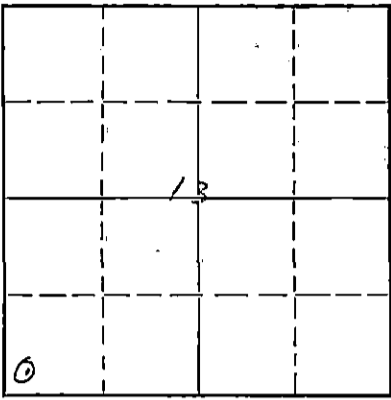

Locate well correctly on above
Section Plat

If a producing well is abandoned, date of last production none 19
Was permission obtained from the Conservation Division or its agents before plugging was commenced? YES

Name of Conservation Agent who supervised plugging of this well Mr. E. R. Petty
Producing formation none Depth to top Bottom Total Depth of Well 3400 Feet
Show depth and thickness of all water, oil and gas formations.

OIL, GAS OR WATER RECORDS

CASING RECORD

Formation	Content	From	To	Size	Put In	Pulled Out
		0	341	7 5/8"	341	NONE

Describe in detail the manner in which the well was plugged, indicating where the mud fluid was placed and the method or methods used in introducing it into the hole. If cement or other plugs were used, state the character of same and depth placed, from 240 feet to 0 feet for each plug set.

Layed down pipe to 1700. Gunned pits to circulate mud. Layed down drill pipe to 240'. Pushed down two Halliburton plug and sack hulls to 240'. Ran 15 sacks cement at 240'. Pushed one Halliburton plug and sack of hull to 50'. Ran 10 sacks cement from 50' to surface.

2-8-51

RECEIVED
STATE CORPORATION COMMISSION
FEB 8 1951
CONSERVATION DIVISION
Wichita, Kansas

(If additional description is necessary, use BACK of this sheet)

Correspondence regarding this well should be addressed to Jack J. Cowden
Address Box 443, Lyons, Kansas

STATE OF Kansas, COUNTY OF Rice, ss.

(employee of owner) or (owner or operator) of the above-described well, being first duly sworn on oath, says: That I have knowledge of the facts, statements, and matters herein contained and the log of the above-described well as filed and that the same are true and correct. So help me God.

(Signature) Jack J. Cowden
Box 443 Lyons, Kansas (Address)

SUBSCRIBED AND SWORN to before me this 5 day of February 1951

Notary Public

My commission expires 12/5/54

28-3278-s 4-60-10M

PLUGGING
FILE SEC-13 T 15 R 11 W
BOOK PAGE 59 LINE 40

15.167.00/69.00.00

W E L L L O G

Continental Oil Company #1 Hoch AA-114
SW SW SW, 13-15S-11W

Casing: 7 5/8 @ 347
Production: D & A
TD 3404

Commenced: 1-12-50
Completed 2- 2-51

TOPS	
Heeb	2863
Br ls	2964
Lens	2980
Marm	3270
Cg.	3312
Arb.	3348

FORMATION

Top Soil	0	37
Shale & ss	37	215
ss & lime	215	246
Shale & ss	246	276
Shale	276	389
Sand	389	420
Shale	420	451
Shale & ss	451	664
Gyp & Anhy	664	694
Anhy. Shale	694	725
Shale & gyp	725	817
Shale & ss	817	878
Shale & gyp & Anh.	878	937
Shale & shells	937	1027
Shale Anhy putt.	1027	1328
Shale & gyp	1328	1419
Shale & Anhy	1419	1450
Gyp & shale	1450	1481
Lime	1481	1511
Lime & shale	1511	2122
Shale & shells	2122	2528
Shale & lime	2528	2541
Lime	2541	2548
Lime & shale	2548	2557
Lime	2557	2559
Lime & shale	2559	2574
Shale	2574	2579
Lime	2579	2597
Lime & shale	2597	2601
Shale	2601	2620
Shale & lime	2620	2670
Lime	2670	2735
Lime & shale	2735	2758
Lime	2758	2866
Shale	2866	2870
Lime	2870	2910
Shale	2910	2958
Lime	2958	3117
Lime & shale	3117	3137
Lime	3137	3271
Lime & shale	3271	3351
Lime	3351	3404

RECEIVED
STATE CORPORATION COMMISSION

MAR - 7 1951

CONSERVATION DIVISION
Wichita, Kansas

PLUGGING
 FILE SEC 13T-15R-11W
 BOOK PAGE 59 LINE 44