


STATE OF KANSAS
STATE CORPORATION COMMISSION

Form CP-4

WELL PLUGGING RECORD

Give All Information Completely
Make Required Affidavit
Mail or Deliver Report to:
Conservation Division
State Corporation Commission
212 No. Market
Wichita, Kansas

NORTH

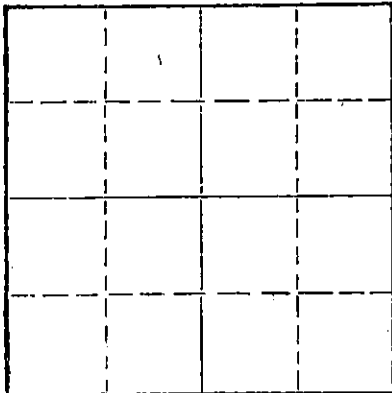

Locate well correctly on above
Section Plat

Russell County, Sec. 8 Twp. 15 Rge. 11 (E) W (W)
Location as "NE/CNW/SW" or footage from lines NW NW NW
Lease Owner Shields Oil Producers, Inc.
Lease Name Nuss Well No. 1
Office Address Shields Building, Russell, Kansas
Character of Well (completed as Oil, Gas or Dry Hole) Dry hole
Date well completed November 21 19 68
Application for plugging filed November 22 19 68
Application for plugging approved November 25 19 68
Plugging commenced November 30 19 68
Plugging completed December 9 19 68
Reason for abandonment of well or producing formation Dry hole

If a producing well is abandoned, date of last production 19
Was permission obtained from the Conservation Division or its agents before plugging was commenced? Yes

Name of Conservation Agent who supervised plugging of this well Don Truan
Producing formation Depth to top Bottom Total Depth of Well 3,392 Feet
Show depth and thickness of all water, oil and gas formations.

OIL, GAS OR WATER RECORDS

CASING RECORD

FORMATION	CONTENT	FROM	TO	SIZE	PUT IN	PULLED OUT
				8 5/8"	261'	Cmtd.
				5 1/2"	3,153'	2,754'

Describe in detail the manner in which the well was plugged, indicating where the mud fluid was placed and the method or methods used in introducing it into the hole. If cement or other plugs were used, state the character of same and depth placed, from 3,392 feet to surface feet for each plug set.

Fill w/ sand to 2,900', dump 5 sax cement on bottom
Pull pipe from hole
Pump 15 sax mud and 90 sax cement down hole to cellar

RECEIVED
JAN 8 1969
STATE CORPORATION COMMISSION
CONSERVATION DIVISION
Wichita, Kansas

1-8-69

(If additional description is necessary, use BACK of this sheet)
Name of Plugging Contractor Barnes & Sons Pipe Pulling Co.
Address P.O. Box 313, Russell, Kansas

STATE OF Kansas COUNTY OF Russell, ss.
R. J. Shields (employee of owner) or (owner or operator) of the above-described well, being first duly sworn on oath, says: That I have knowledge of the facts, statements, and matters herein contained and the log of the above-described well as filed and that the same are true and correct. So help me God.

(Signature)

Shields Building, Russell, Kansas

(Address)

SUBSCRIBED AND SWORN to before me this 7th day of January, 19 69

My commission expires

May 26, 1971

Luth Phillips

Notary Public.