


STATE OF KANSAS
STATE CORPORATION COMMISSION

Give All Information Completely
Make Required Affidavit
Mail or Deliver Report to:
Conservation Division
State Corporation Commission
211 No. Broadway
Wichita, Kansas

WELL PLUGGING RECORD

Stafford County. Sec. 2 Twp. 24S Rge. 15W (E) (W)
Location as "NE/CNW/SW" or footage from lines SE SW SW
Lease Owner Hellar Drilling Company, Inc.
Lease Name Doran Well No. 1
Office Address 1014 Union Center, Wichita, Kansas 67202
Character of Well (completed as Oil, Gas or Dry Hole) Dry Hole
Date well completed October 9 1965
Application for plugging filed October 9 1965
Application for plugging approved October 9 1965
Plugging commenced October 9 1965
Plugging completed October 9 1965
Reason for abandonment of well or producing formation Dry Hole

NORTH

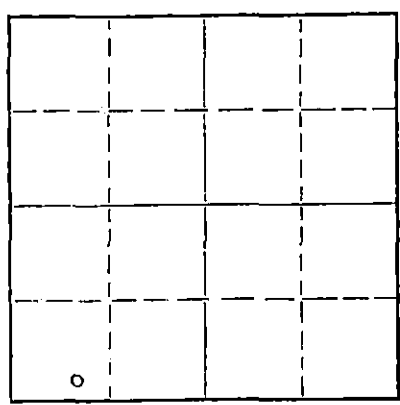

Locate well correctly on above
Section Plat

If a producing well is abandoned, date of last production 19
Was permission obtained from the Conservation Division or its agents before plugging was commenced? Yes

Name of Conservation Agent who supervised plugging of this well A. Elving, Box 248, Pratt, Kansas
Producing formation _____ Depth to top _____ Bottom _____ Total Depth of Well 4110 Feet
Show depth and thickness of all water, oil and gas formations.

OIL, GAS OR WATER RECORDS

CASING RECORD

FORMATION	CONTENT	FROM	TO	SIZE	PUT IN	PULLED OUT
		0	251'	8 5/8"	251'	None

Describe in detail the manner in which the well was plugged, indicating where the mud fluid was placed and the method or methods used in introducing it into the hole. If cement or other plugs were used, state the character of same and depth placed, from _____ feet to _____ feet for each plug set.

Set Plug: 240'/25 sacks cement & 1/4 sack hulls
40'/15 sacks cement & 1/4 sack hulls

RECEIVED
STATE CORPORATION COMMISSION

OCT 25 1965

CONSERVATION DIVISION
Wichita, Kansas

(If additional description is necessary, use BACK of this sheet)

Name of Plugging Contractor Hellar Drilling Company, Inc.
Address 1014 Union Center, Wichita, Kansas 67202

STATE OF Kansas, COUNTY OF Sedgwick, ss.
D. L. Hellar, Pres. of Hellar Drilling Co. (employee of owner) or (owner or operator) of the above-described well, being first duly sworn on oath, says: That I have knowledge of the facts, statements, and matters herein contained and the log of the above-described well as filed and that the same are true and correct. So help me God.

(Signature) D. L. Hellar D. L. Hellar, President
1014 Union Center, Wichita, Kansas 67202
(Address)

SUBSCRIBED AND SWORN to before me this 21st day of October, 1965

My commission expires March 25, 1968.

Catherine Darcey
Catherine Darcey - Notary Public.

DRILLER'S LOG

COMPANY: Hellar Drilling Company, Inc., Wichita, Kansas
 CONTRACTOR: Hellar Drilling Company, Inc., Wichita, Kansas
 LEASE: #1 Doran
 LOCATION: SE SW SW 2-24S-15W, Stafford County, Kansas
 COMMENCED: September 26, 1965
 COMPLETED: October 9, 1965
 CASING: Set 8 5/8" surface casing @ 251'/225 sacks cement

0-305	Surface soil, sand and gravel
305-944	Red Bed & shale & sand streaks
944-965	Anhydrite
965-1240	Shale & Red Bed
1240-1720	Shale & Shells
1720-1936	Shale w/Lime Streaks
1936-2094	Lime & Shale
2094-2515	Shale & Lime
2515-2699	Lime & Shale
2699-2870	Shale & Lime
2870-3496	Lime & Shale
3496-3528	Shale & Lime
3528-3596	Douglas Shale
3596-3702	Shale & Lime
3702-3783	Lime & Shale
3783-3903	Lime
3903-4068	Lime & Shale
4068-4088	Lime
4088-4096	Sand
4096-4110	Simpson Shale & dolomite
4110	Rotary Total Depth
	Dry & Abandoned

RECEIVED
 STATE GEOLOGICAL COMMISSION
 OCT 25 1965
 NOTARY PUBLIC
 Sedgwick County, Kansas

STATE OF KANSAS)
) ss
 COUNTY OF SEDGWICK)

I, D. L. Hellar, do hereby certify that the above and foregoing is a true and correct copy of the log of the #1 Doran, located in SE SW SW 2-24S-15W, Stafford County, Kansas, as reflected by the files of the Hellar Drilling Company, Inc.

HELLAR DRILLING COMPANY, INC.

By *D. L. Hellar*
 President - D. L. Hellar

Subscribed and sworn to before me, a Notary Public, in and for Sedgwick County, Kansas, this 21st day of October, 1965.

My Commission Expires:
 March 25, 1968.

Catherine Darcey
 Notary Public - Catherine Darcey