


Give All Information Completely
Make Required Affidavit
Mail or Deliver Report to:
Conservation Division
State Corporation Commission
212 North Market, Insurance Bldg.
Wichita, Kansas

WELL PLUGGING RECORD

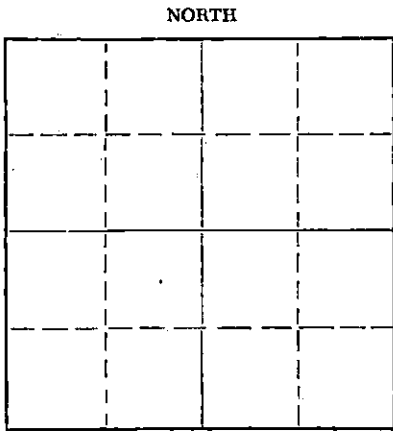

Locate well correctly on above Section Plat

Stafford County, Sec. 32 Twp. 24 Rge. 13W (E) (W)
Location as "NE/CNW/SW" or footage from lines SW SE NW
Lease Owner Burch Drilling Co., Inc.
Lease Name Harris Well No. 1
Office Address 1011 Union Center, Wichita, Kansas
Character of Well (completed as Oil, Gas or Dry Hole) Dry Hole
Date well completed 5-20 1959
Application for plugging filed 5-20 1959
Application for plugging approved 5-20 1959
Plugging commenced 5-20 1959
Plugging completed 5-20 1959
Reason for abandonment of well or producing formation Dry

If a producing well is abandoned, date of last production 19
Was permission obtained from the Conservation Division or its agents before plugging was commenced? Yes, orally

Name of Conservation Agent who supervised plugging of this well Frank Broadfoot
Producing formation _____ Depth to top _____ Bottom _____ Total Depth of Well 4290 Feet
Show depth and thickness of all water, oil and gas formations.

OIL, GAS OR WATER RECORDS

CASING RECORD

FORMATION	CONTENT	FROM	TO	SIZE	PUT IN	PULLED OUT
		0	265'	8 5/8"	267.93'	None

Describe in detail the manner in which the well was plugged, indicating where the mud fluid was placed and the method or methods used in introducing it into the hole. If cement or other plugs were used, state the character of same and depth placed, from _____ feet to _____ feet for each plug set.

Set bottom plug at 240' with 1/2 sacks hulls and 20 sacks cement. Filled hole with mud to 20', set second plug with 1/2 sack hulls and 10 sacks cement.

RECEIVED
STATE CORPORATION COMMISSION

MAY 26 1959

CONSERVATION DIVISION
Wichita, Kansas

(If additional description is necessary, use BACK of this sheet)

Name of Plugging Contractor Hellar Drilling Company, Inc.
Address 1014 Union Center, Wichita, Kansas

STATE OF KANSAS, COUNTY OF SEDGWICK, ss.
I, D. L. Hellar, President (employee of owner) or (owner or operator) of the above described well being first duly sworn on oath, says: That I have knowledge of the facts, statements, and matters herein contained and the log of the above-described well as filed and that the same are true and correct. So help me God.

(Signature) _____ by D. L. Hellar
HELLAR DRILLING COMPANY, INC.
1014 Union Center
(Address)

SUBSCRIBED AND SWORN TO before me this 25th day of May, 19 59

Wanda Lou Bruce
Notary Public.

My commission expires March 6, 1961.

PLUGGING
FILE SEC 321.24 R.134
BOOK PAGE 21 LINE 22

CONTRACTOR'S WELL LOG

COMPANY:	BURCH DRILLING CO., INC.
CONTRACTOR:	HELLAR DRILLING COMPANY, INC.
FARM:	HARRIS #1
LOCATION:	SW SE NW SEC. 34-24-13W STAFFORD COUNTY, KANSAS
COMMENCED:	MAY 4, 1959
COMPLETED:	MAY 19, 1959
SURFACE CASING:	267.93' 8-5/8" SET AT 265' WITH 225 SACKS CEMENT

0	100	Sand & Clay
100	265	Red bed
265	795	Shale & Sand
795	1500	Shale & red bed
1500	1740	Shale
1740	1940	Sand & Shale
1940	2610	Lime & Shale
2610	2800	Shale
2800	2985	Shale & Lime
2985	3113	Lime & Shale
3113	3290	Shale & Lime
3290	3517	Lime
3517	3735	Lime & Shale
3735	3910	Lime
3910	4015	Lime & Shale
4015	4077	Lime & Chert
4077	4084	Cherty Lime
4084	4095	Lime
4095	4135	Chert & Lime
4135	4222	Cherty Lime
4222	4223	Lime
4223	4263	Lime & Shale
4263	4290	Arbuckle
	4290	Total Depth D & A

RECEIVED
STATE CORPORATION COMMISSION
MAY 26 1959
CONSERVATION DIVISION
Wichita, Kansas

STATE OF KANSAS)
) SS
COUNTY OF SEDGWICK)

I, D. L. Hellar, do hereby certify that the above and foregoing is a true and correct copy of the log of the HARRIS #1, SW SE NW of Section 34-24-13W, Stafford County, Kansas, as reflected by the files of the Hellar Drilling Company, Inc.

HELLAR DRILLING COMPANY, INC.

BY *D. L. Hellar*
President

Subscribed and sworn to before me, a Notary Public, in and for Sedgwick County, Kansas, this 22nd day of May, 1959.

PLUGGING
FILE SEC. 82T 24R 13W
BOOK PAGE 44 LINE 10

Handa Lou Bruce
Notary Public