


WELL PLUGGING RECORD

Give All Information Completely
Make Required Affidavit
Mail or Deliver Report to:
Conservation Division
State Corporation Commission
800 Bittling Building
Wichita, Kansas

Stafford County, Sec. 32 Twp. 24S Rge. 13 (E) (W)
Location as "NE/CNW&SW" or footage from lines C NW NE NW
Lease Owner Cooperative Refinery Ass'n.
Lease Name Copeland Well No. 1
Office Address Box 765 Gt. Bend, Kansas
Character of Well (completed as Oil, Gas or Dry Hole) Dry hole
Date well completed July 19 19 56
Application for plugging filed July 18 19 56
Application for plugging approved Verbal permission obtained 19
Plugging commenced July 19 19 56
Plugging completed July 19 19 56
Reason for abandonment of well or producing formation
Dry hole

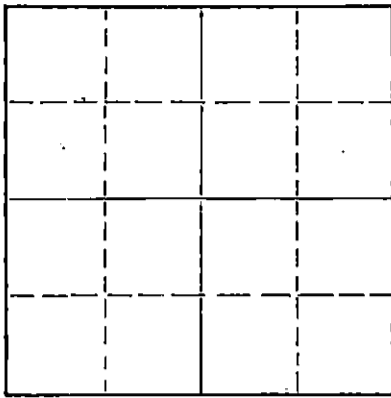

Locate well correctly on above Section Plat

If a producing well is abandoned, date of last production 19
Was permission obtained from the Conservation Division or its agents before plugging was commenced?

Name of Conservation Agent who supervised plugging of this well Mr. R. M. Brundege
Producing formation Depth to top Bottom Total Depth of Well 4250 Feet
Show depth and thickness of all water, oil and gas formations.

OIL, GAS OR WATER RECORDS

CASING RECORD

FORMATION	CONTENT	FROM	TO	SIZE	PUT IN	PULLED OUT
				8 5/8	245'	

Describe in detail the manner in which the well was plugged, indicating where the mud fluid was placed and the method or methods used in introducing it into the hole. If cement or other plugs were used, state the character of same and depth placed, from feet to feet for each plug set.

Filled with heavy mud to 240'. Set plug with 1/3 sx. hulls
Cemented thru drill pipe with 20 sx. Set 2nd plug at 35' with
1/4 sx. hulls. Cemented with 10 sx. to surface.

7-20-56

(If additional description is necessary, use BACK of this sheet)
Name of Plugging Contractor Rex-Morris Drlg. Company
Address El Dorado, Kansas

STATE OF KANSAS, COUNTY OF BARTON, ss.
M. D. Sullivan (employee of owner) or (owner or operator) of the above-described well, being first duly sworn on oath, says: That I have knowledge of the facts, statements, and matters herein contained and the log of the above-described well as filed and that the same are true and correct. So help me God

(Signature) M. D. Sullivan
Box 765 Gt. Bend, Kansas (Address)

SUBSCRIBED AND SWORN TO before me this 19 day of July 19 56
Ruth W. Love Notary Public.

My commission expires September 2, 1959

PLUGGING
FILE SEC. 32 T. 24 R. 13 W
BOOK PAGE 82 LINE 4

DRILLERS LOG

Copeland #1

Loc: G NW NE NW
 Sec: 32-24S-13W
 Stafford County, Kansas
 Operator: Cooperative Refinery Ass'n.
 Contractor: Rex-Morris Drilling Co.

Elevation: 1947 R.B.
 Casing: 8 5/8" at 245' w/ 225 sx
 Comm: 7-6-56 Comp: 7-19-56
 Total Depth: 4250 R.T.D.

<u>From</u>	<u>To</u>	<u>Formation</u>
0	246	Surface hole
246	835	Shale, sand, red bed
835	1020	Shells
1020	3335	Shale and lime
3335	3392	Lime
3392	3603	Lime and shale
3603	3863	Lime
3863	4115	Lime and shale
4115	4230	Lime
4230	4250	Arbuckle
4250		R.T.D.

(STATE OF KANSAS)

(COUNTY OF BARTON)

I hereby certify that the above is a true and correct copy of the log on the Copeland #1 well, located G NW NE NW of Section 32-24S-13W, Stafford County, Kansas.

P. A. Jackson

Subscribed and sworn to before me this 18 day of July 1956.

Ruth V. Love

My commission expires: September 2, 1959

STATE OF KANSAS
 JUL 19 1956
 COUNTY OF BARTON

PLUGGING
 FILE SEC 32 T 24 R 13W
 BOOK PAGE 82 LINE 4