


STATE OF KANSAS  
STATE CORPORATION COMMISSION

Give All Information Completely  
Make Required Affidavit  
Mail or Deliver Report to:  
Conservation Division  
State Corporation Commission  
211 No. Broadway  
Wichita, Kansas

15-185-12176-0000

WELL PLUGGING RECORD

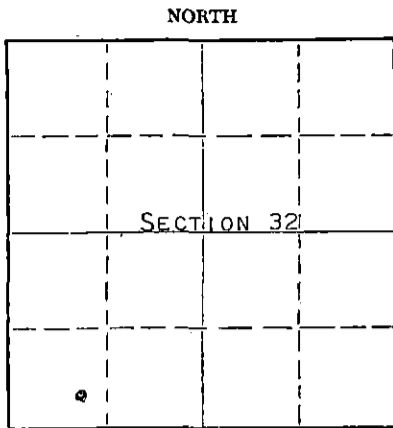

Locate well correctly on above Section Plat

STAFFORD County. Sec. 32 Twp. 24S Rge. 13W XX) X(W)  
Location as "NE/CNW/SW" or footage from lines NE SW SW  
Lease Owner PETROLEUM, INC.  
Lease Name BELOTE Well No. 4  
Office Address ROUTE 2, GREAT BEND, KANSAS  
Character of Well (completed as Oil, Gas or Dry Hole) DRY HOLE  
Date well completed MARCH 11, 19 62  
Application for plugging filed MARCH 11, 19 62  
Application for plugging approved MARCH 11, 19 62  
Plugging commenced MARCH 11, 19 62  
Plugging completed MARCH 11, 19 62  
Reason for abandonment of well or producing formation NO PRODUCIBLE FORMATIONS.

If a producing well is abandoned, date of last production NONE 19       
Was permission obtained from the Conservation Division or its agents before plugging was commenced? YES

Name of Conservation Agent who supervised plugging of this well W. L. LACKAMP, JR.  
Producing formation      Depth to top      Bottom      Total Depth of Well 3910 Feet  
Show depth and thickness of all water, oil and gas formations.

OIL, GAS OR WATER RECORDS

CASING RECORD

FORMATION	CONTENT	FROM	TO	SIZE	PUT IN	PULLED OUT
				8-5/8"	255'	NONE

Describe in detail the manner in which the well was plugged, indicating where the mud fluid was placed and the method or methods used in introducing it into the hole. If cement or other plugs were used, state the character of same and depth placed, from      feet to      feet for each plug set.

MUDDED UP WITH HEAVY MUD TO 240' FOLLOWED BY WOODEN PLUG. PLACED 20 SACKS CEMENT THROUGH DRILL PIPE ONTO PLUG. MUDDED UP WITH HEAVY MUD TO 35' FOLLOWED BY WOODEN PLUG AND 10 SACKS CEMENT TO BASE OF WELL CELLAR.

RECEIVED  
STATE CORPORATION COMMISSION

APR 2 1962

CONSERVATION DIVISION  
Wichita, Kansas

4-23-62

(If additional description is necessary, use BACK of this sheet)  
Name of Plugging Contractor GARVEY DRILLING COMPANY  
Address ROUTE 2, GREAT BEND, KANSAS

STATE OF KANSAS, COUNTY OF BARTON, ss.  
DON SEARLE (employee of owner) or (~~owner or operator~~) of the above-described well, being first duly sworn on oath, says: That I have knowledge of the facts, statements, and matters herein contained and the log of the above-described well as filed and that the same are true and correct. So help me God. DON SEARLE, DIST. PROD. SUPT.

(Signature) Don Searle  
ROUTE 2, GREAT BEND, KANSAS  
(Address)

SUBSCRIBED AND SWORN TO before me this 19TH day of APRIL, 19 62

My commission expires APRIL 14, 1963

Arthur J. Wiles  
Notary Public.

# WELL LOG

15-185-12176-0000

COMPANY PETROLEUM, INCORPORATED

SEC. 32 T. 24S R. 13W

FARM BELOTE NO. 4


LOC. NE, SW, SW

TOTAL DEPTH 3910'

COUNTY STAFFORD CO., KANSAS

COMM. March 4, 1962 COMP. March 11, 1962

CONTRACTOR GARVEY DRILLING COMPANY

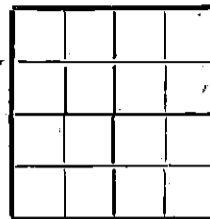

CASING 8-5/8" @ 255' w/225 sax.

ELEVATION 1942' D.F.

PRODUCTION D & A

FIGURES INDICATE BOTTOM OF FORMATIONS

155	Surface soil & sand.
255	Red bed
830	Red bed & shale
855	Anhydrite
865	Shale & shells
1500	Shale
1875	Lime & shale
2130	Lime
2295	Lime & shale
2965	Shale & lime
3105	Lime & shale
3515	Lime
3660	Lime & shale
3910	Lime
3910	T. D.

**RECEIVED**  
STATE CORPORATION COMMISSION

APR 23 1962

CONSERVATION DIVISION  
Wichita, Kansas

State of KANSAS  
County of BARTON } ss

I, VERNE A. MORRIS of GARVEY DRILLING COMPANY

upon oath state the above and foregoing is a true and correct copy of the log of the #4 BELOTE well.

*Verne A. Morris*

Subscribed and sworn to before me this 19th day of April 1962

My Commission Expires: April 14, 1963

*Arthur J. Miles*  
NOTARY PUBLIC