


WELL PLUGGING RECORD

Give All Information Completely
Make Required Affidavit
Mail or Deliver Report to:
Conservation Division
State Corporation Commission
212 North Market, Insurance Bldg.
Wichita, Kansas

STAFFORD County. Sec. 32 Twp. 24s Rge. 13w (#) (W)

Location as "NE/CNW/SW" or footage from lines NW SW SE
Lease Owner PETROLEUM, INC.
Lease Name GLASSCOCK "B" Well No. 1
Office Address ROUTE 2, GREAT BEND, KANSAS
Character of Well (completed as Oil, Gas or Dry Hole) DRY HOLE
Date well completed MAY 31 1960
Application for plugging filed MAY 31 1960
Application for plugging approved MAY 31 1960
Plugging commenced MAY 31 1960
Plugging completed MAY 31 1960
Reason for abandonment of well or producing formation HOLE DEVIATION - FORCED TO SKID RIG TO NEW LOCATION
If a producing well is abandoned, date of last production NONE 19
Was permission obtained from the Conservation Division or its agents before plugging was commenced? YES

NORTH

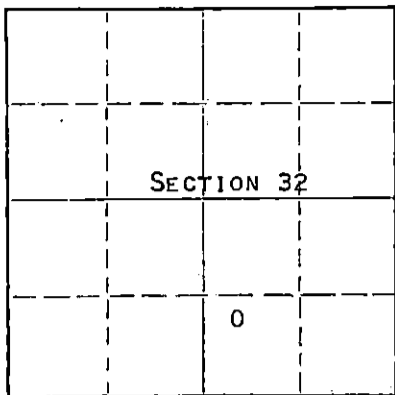

Locate well correctly on above Section Plat

Name of Conservation Agent who supervised plugging of this well FRANK BROADFOOT
Producing formation _____ Depth to top _____ Bottom _____ Total Depth of Well 414 Feet
Show depth and thickness of all water, oil and gas formations.

OIL, GAS OR WATER RECORDS

CASING RECORD

FORMATION	CONTENT	FROM	TO	SIZE	PUT IN	PULLED OUT
				8-5/8"	214'	NONE

Describe in detail the manner in which the well was plugged, indicating where the mud fluid was placed and the method or methods used in introducing it into the hole. If cement or other plugs were used, state the character of same and depth placed, from _____ feet to _____ feet for each plug set.

MUDDED UP WITH HEAVY MUD TO 205' FOLLOWED BY WOODEN PLUG AND 1/3 SACK HULLS, PLACED 20 SACKS CEMENT THROUGH DRILL PIPE ONTO HULLS, MUD UP WITH HEAVY MUD TO 35' FOLLOWED BY 1/8 SACK HULLS, WOODEN PLUG, AND 10 SACKS CEMENT TO BASE OF WELL CELLAR.

RECEIVED
STATE CORPORATION COMMISSION
JUN 10 1960
CONSERVATION DIVISION
Wichita, Kansas

(If additional description is necessary, use BACK of this sheet)

Name of Plugging Contractor GARVEY DRILLING COMPANY
Address ROUTE 2, GREAT BEND, KANSAS

STATE OF KANSAS, COUNTY OF BARTON, ss.
DON SEARLE (employee of owner) or (owner) of the above-described well, being first duly sworn on oath, says: That I have knowledge of the facts, statements, and matters herein contained and the log of the above-described well as filed and that the same are true and correct. So help me God.

(Signature) Don Searle
ROUTE 2, GREAT BEND, KANSAS
(Address)

SUBSCRIBED AND SWORN TO before me this 8TH day of JUNE, 1960

My commission expires APRIL 14, 1963 Notary Public.



R
WELL LOG

15-185-19030-0000

COMPANY PETROLEUM, INCORPORATED

SEC. 32 T.24S R. 13W

FARM GLASSCOCK "B" NO. 1

LOC. NW, SW, SE


TOTAL DEPTH 414'

COUNTY STAFFORD CO., KANSAS

COMM. May 31, 1960

COMP. May 31, 1960

CONTRACTOR GARVEY DRILLING COMPANY

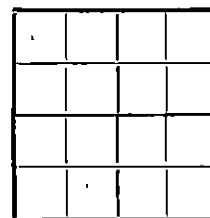

CASING 8 5/8" @ 214' w/200 sax.

ELEVATION 1948' DF

PRODUCTION Plugged & Abandon

FIGURES INDICATE BOTTOM OF FORMATIONS

151	Surface soil & sand
165	Sand & clay
214	Shale
414	Red bed & shale
414	T. D.

Hole deviation - forced to skid rig to new location.

RECEIVED
STATE CORPORATION COMMISSION
JUN 10 1960
CONSERVATION DIVISION
Wichita, Kansas

State of KANSAS }
County of BARTON } ss.

I, VERNE A. MORRIS of GARVEY DRILLING COMPANY

upon oath state that the above and foregoing is a true and correct copy of the log of the #1 GLASSCOCK "B" well

Verne A. Morris

Subscribed and sworn to before me this 7th day of June 19 60

My Commission Expires: April 14, 1963

Arthur J. Wile
NOTARY PUBLIC