


STATE OF KANSAS
STATE CORPORATION COMMISSION

Give All Information Completely
Make Required Affidavit
Mail or Deliver Report to:
Conservation Division
State Corporation Commission
211 No. Broadway
Wichita, Kansas

WELL PLUGGING RECORD

NORTH

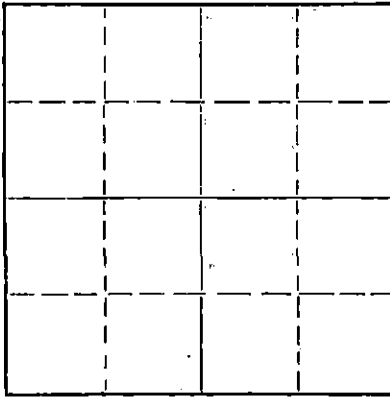

Locate well correctly on above
Section Plat

Harvey County. Sec. 12 Twp. 24S Rge. 1 ~~X000~~ (W)
Location as "NE/CNW/SW" or footage from lines: SE SE SE
Lease Owner Cherry Drilling Company
Lease Name Briggs Well No. 1
Office Address 102 Insurance Building, Wichita, Kansas
Character of Well (completed as Oil, Gas or Dry Hole) Dry Hole
Date well completed 11-17 1957
Application for plugging filed 11-17 1957
Application for plugging approved 11-17 1957
Plugging commenced 11-17 1957
Plugging completed 11-18 1957
Reason for abandonment of well or producing formation _____

If a producing well is abandoned, date of last production _____ 19____
Was permission obtained from the Conservation Division or its agents before plugging was commenced? yes

Name of Conservation Agent who supervised plugging of this well Ruel Durkee
Producing formation _____ Depth to top _____ Bottom _____ Total Depth of Well 3608 Feet
Show depth and thickness of all water, oil and gas formations.

OIL, GAS OR WATER RECORDS

CASING RECORD

FORMATION	CONTENT	FROM	TO	SIZE	PUT IN	PULLED OUT
				8-5/8"	217'	none

Describe in detail the manner in which the well was plugged, indicating where the mud fluid was placed and the method or methods used in introducing it into the hole. If cement or other plugs were used, state the character of same and depth placed, from _____ feet to _____ feet for each plug set.

Filled with heavy mud to 202' - set bottom plug at 202' poured 15 sacks of cement through drill pipe - filled with heavy mud to 17' - filled with 5 sacks cement. Rat hole plugged with 3 sacks of cement.

11-27-57

RECEIVED
STATE CORPORATION COMMISSION

NOV 27 1957

CONSERVATION DIVISION
Wichita, Kansas

(If additional description is necessary, use BACK of this sheet)

Name of Plugging Contractor Red Drilling Company
Address Box 786, El Dorado, Kansas

STATE OF Kansas, COUNTY OF Butler, ss.
O. N. Wilson (employee of owner) or (owner or operator) of the above-described well, being first duly sworn on oath, says: That I have knowledge of the facts, statements, and matters herein contained and the log of the above-described well as filed and that the same are true and correct. So help me God.

RED DRILLING COMPANY
(Signature) O. N. Wilson BY [Signature]
O. N. Wilson
(Address)

SUBSCRIBED AND SWORN to before me this 25th day of November, 1957

[Signature]
Notary Public.

My commission expires March 3, 1959

PLUGGING
FILE SEC. 12 T. 24 R. 1W
BOOK PAGE 62 LINE 19

WELL LOG

15-079-00089-0000

Operator Cherry Drilling Company
 Comm 11-4-57 Comp 11-17-57
 Shot _____ Qts. From _____ ft. To _____ ft.
 Acidized _____ Gal. _____
 Prod. Formation _____
 Initial Prod. Dry Hole
 Elevation _____ Cemented _____

Lease Briggs Well No. 1
 Loc SE SE SE Sec 12 Twp 24S Rge 1W
 County Harvey State Kansas
 Contractor Red Drilling Company
 Casing Record

Size	Ft.	Pulled	Remarks
8-5/8"	217'	W/200 Sacks &	3% C.C.

FIGURES INDICATE BOTTOM OF FORMATION

- 100 sand & shale
- 135 shale & lime strks
- 380 shale & lime
- 610 lime & shale
- 690 shale & lime
- 1000 lime
- 1135 lime & shale
- 1150 shale & lime
- 1455 shale
- 1675 shale & lime strks
- 1740 sandy shale
- 1775 shale & lime strks
- 1840 shale & lime
- 1975 lime & shale
- 2100 shale & lime
- 2350 shale
- 2460 lime & shale
- 2510 lime
- 2555 lime & shale
- 2772 lime
- 2848 shale & lime strks
- 2929 lime
- 3044 lime & shale
- 3360 lime
- 3420 lime & shale
- 3452 shale
- 3497 lime
- 3548 shale
- 3608 lime & shale

Total Depth - 3608'

This is to certify that the above log is true and correct.

RED DRILLING COMPANY
 BY O. N. Wilson
 O. N. Wilson

Subscribed and sworn to before me this 25th day of November, 1957.

Edith S. Riggall
 Notary Public

My commission expires March 3, 1959.

NOV 27 1957
 REGISTRATION DIVISION
 Wichita, Kansas

PLUGGING
 FILE SEC 12 T 24 R 1W
 BOOK PAGE 62 LINE 19