

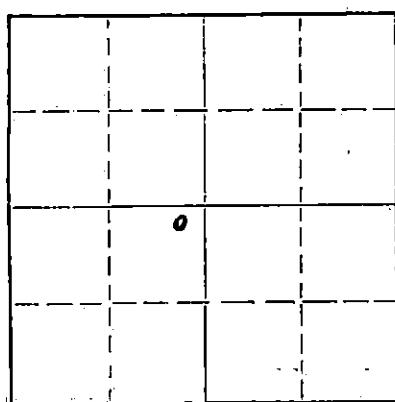
STATE OF KANSAS
STATE CORPORATION COMMISSION

Give All Information Completely

Make Required Affidavit

Mail or Deliver Report to:
Conservation Division
State Corporation Commission
211 No. Broadway
Wichita, Kansas

NORTH

Locate well correctly on above
Section Plat

Name of Conservation Agent who supervised plugging of this well

Producing formation _____ Depth to top _____ Bottom _____ Total Depth of Well 3679' Feet

Show depth and thickness of all water, oil and gas formations.

OIL, GAS OR WATER RECORDS

FORMATION	CONTENT	FROM	TO	SIZE	PUT IN	PULLED OUT

Describe in detail the manner in which the well was plugged, indicating where the mud fluid was placed and the method or methods used in introducing it into the hole. If cement or other plugs were used, state the character of same and depth placed, from 3679 feet to 200 feet for each plug set.

Mud from total depth to 200 ft. $\frac{1}{4}$ sack hulls, bridge plug and 20 sacks cement, Mud to 40 ft. $\frac{1}{4}$ sack hulls bridge plug and 8 sacks cement to bottom of cellar--2 sacks in rathole.

RECEIVED
STATE CORPORATION COMMISSION

APR 24 1964

CONSERVATION DIVISION
Wichita, Kansas

(If additional description is necessary, use BACK of this sheet)

Name of Plugging Contractor German Drilling Company
Address 502 Petroleum Building, Wichita, Kansas 67202

STATE OF Kansas, COUNTY OF Sedgwick, ss.
Harvey F. German (employee of owner) or (owner or operator) of the above-described well, being first duly sworn on oath, says: That I have knowledge of the facts, statements, and matters herein contained and the log of the above-described well as filed and that the same are true and correct. So help me God.

(Signature)

Harvey F. German
502 Petroleum Building, Wichita, Kansas
(Address)

SUBSCRIBED AND SWORN TO before me this 21st day of April 19 64

My commission expires February 28th, 1968.

Geneva M. German

Notary Public

WELL LOG -- Manning #1

OPERATOR: Dale Frey
 Parklane Towers
 Lincoln and Oliver
 Wichita, Kansas

LOCATION: NE-NE-SW

14-24-1W
 Harvey County
 Kansas

CONTRACTOR: German Drilling Company
 502 Petroleum Building
 Wichita, Kansas

Farm: Manning
 Date Commenced: 4-10-64
 Date Completed: 4-20-64

Well No. 1

Rotary

<u>From</u>	<u>To</u>	<u>Formation</u>
60	202	Shale
203	560	Shale and lime
560	860	Shale and lime
860	1110	Shale and lime
1110	1660	Shale and lime
1660	1940	Shale and lime
1940	2095	Lime and shale
2095	2241	Lime and shale
2241	2322	Shale and lime
2322	2344	Lime
2344	2389	Shale
2389	2409	Lime (Lansing)
2409	2500	Lime
2500	2574	Lime and chert
2574	2578	Lime and chert
2578	2713	Lime and chert
2713	2794	Lime and chert
2794	2800	Lime and shale
2800	2910	Shale and lime
2910	3007	Lime and shale
3007	3065	Shale and lime
3065	3091	Shale and lime
3091	3127	Lime
3127	3185	Lime
3185	3264	Lime and chert
3264	3316	Lime and chert
3316	3360	Lime and chert
3360	3395	Lime
3395	3432	Lime
3432	3450	Lime
3450	3498	Shale
3498	3517	Shale
3517	3520	Sand (Misner)
3520	3542	Lime (Hunton)
3542	3566	Lime
3566	3609	Shale (Maquokata)
3609	3612	Lime (Viola)
3612	3635	Lime
3635	3665	Sand
3665	3679	Sand
3679		Total Depth ✓

I hereby certify that the foregoing is a true and correct copy of the Well Log for the Manning #1, drilled for Dale Frey and completed April 20th, 1964.

GERMAN DRILLING COMPANY

By Harvey F. German
 Harvey F. German

STATE OF KANSAS }
 COUNTY OF SEDGWICK } ss.
)

Subscribed and sworn to, before the undersigned a Notary Public, in and for County and State aforesaid this twenty-first day of April, 1964.

Geneva M. German
 Geneva M. German

My commission expires February 28th, 1968.

RECEIVE
 STATE CORPORATION COMMISSION
 APR 24 1964
 CONSERVATION DIVISION
 Wichita, Kansas