

STATE OF KANSAS
STATE CORPORATION COMMISSION


Give All Information Completely
Make Required Affidavit
Mail or Deliver Report to:
Conservation Division
State Corporation Commission
800 Bittling Building
Wichita, Kansas

WELL PLUGGING RECORD

FORMATION PLUGGING RECORD

Strike out upper line
when reporting plug-
ging off formations.

NORTH

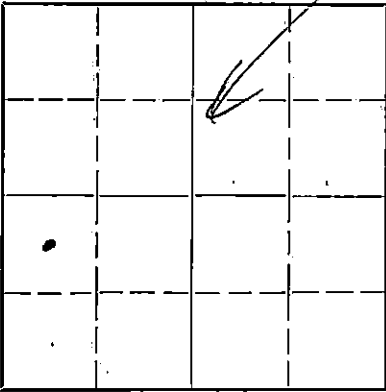

Locate well correctly on above
Section Plat

Harvey County. Sec. *1* Twp. *24* Rge. *(E) 2 (W)*
Location as "NE $\frac{1}{4}$ NW $\frac{1}{4}$ SW $\frac{1}{4}$ " or footage from lines
Lease Owner *Harvey & Brannin*
Lease Name *Mc Cune* Well No. *1*
Office Address *Newton, Kansas*
Character of Well (completed as Oil, Gas or Dry Hole) *Dry Hole*
Date well completed *May 6* 19*43*
Application for plugging filed *May 8* 19*43*
Application for plugging approved *May 8* 19*43*
Plugging commenced *May 10* 19*43*
Plugging completed *May 14* 19*43*
Reason for abandonment of well or producing formation *Dry*

If a producing well is abandoned, date of last production 19
Was permission obtained from the Conservation Division or its agents before plugging was com-
menced? *Yes*

Name of Conservation Agent who supervised plugging of this well *Ruel Hurker*
Producing formation Depth to top Bottom Total Depth of Well *3270* Feet
Show depth and thickness of all water, oil and gas formations.



OIL, GAS OR WATER RECORDS

CASING RECORD

Formation	Content	From	To	Size	Put In	Pulled Out
<i>Sand</i>	<i>water</i>	<i>203</i>	<i>200</i>		<i>10.20"</i>	<i>60' - 20"</i>
<i>Sand</i>	<i>water</i>	<i>720</i>	<i>730</i>	<i>12"</i>	<i>1103</i>	<i>1183</i>
<i>Sand</i>	<i>water</i>	<i>1020</i>	<i>1030</i>	<i>10"</i>	<i>1998</i>	<i>1998</i>
<i>Sand</i>	<i>water</i>	<i>1735</i>	<i>1740</i>	<i>8"</i>	<i>2450</i>	<i>2450</i>
<i>Sand</i>	<i>water</i>	<i>2495</i>	<i>2500</i>	<i>5"</i>	<i>3010</i>	<i>3010</i>
<i>Sand</i>	<i>water</i>	<i>2741</i>	<i>2765</i>			

Describe in detail the manner in which the well was plugged, indicating where the mud fluid was placed and the method or methods used in
introducing it into the hold. If cement or other plugs were used, state the character of same and depth placed, from *2450* feet to
400 feet for each plug set.

Mud From 2450 to 400'
Cement Plug 380 to 400'
Mud to surface
Cement Plug at surface

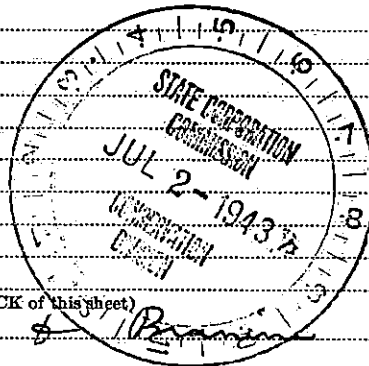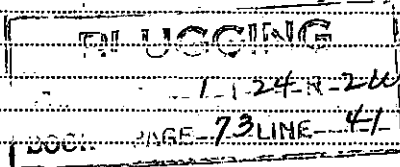

(If additional description is necessary, use BACK of this sheet)
Correspondence regarding this well should be addressed to *Harvey & Brannin*
Address *Newton, Kansas*

STATE OF *Kans*, COUNTY OF *Harvey*, ss.
(employee of owner) or (owner or operator) of the above-described well,
being first duly sworn on oath, says: That I have knowledge of the facts, statements, and matters herein contained and the log of the above-
described well as filed and that the same are true and correct. So help me God.

(Signature) *Mike Harber*
Mc Pherson, Kansas
(Address)

SUBSCRIBED AND SWORN to before me this *1* day of *July*, 19*43*
Joe E. Neek
Notary Public.

My commission expires *March 26 1947*

FESTER & HARPER DRILLING CO.
McPherson, Kansas

McCune #1 SW $\frac{1}{4}$ Sec. 1-24-2 West
Harvey County Aldin Branine
& Others

	Feet		Feet		Feet
Shale	0 - 10	Lime	780	Shale	1850
Sand H F W	25	Shale	800	Lime	1865
Gip Rock	35	Lime	820	Shale	1998
Shale	45	Shale	825	Lime (10" P. 1998)	2010
Sand	50	Lime	830	Shale	2015
Shale	65	Shale	840	Lime	2030
Lime	75	Lime Broken	855	Shale	2075
Shale	97	Sand	865	Lime	2235
Lime	115	Shale	940	Shale	2255
Lime & Shells	160	Red Rock	945	Lime	2290
Lime	170	Sand	955	Sandy Lime	2300
Shale	180	Shale	985	Shale	2305
Lime	190	Lime	1000	Lime	2338
Red Rock	198	Shale	1010	Shale	2343
Shale Blue	203	Sand 2 B.W.	1020	Lime	2416
Lime	240	Shale	1065	Shale	2425
Shale	245	Lime	1070	Lime (8" P. 2450)	2457
Lime	250	Shale (12" P. 1103)	1105	Water Sand H F W	2495
Lime & Shells	275	Lime	1110	Lime (U R P to 250)	2517
Lime	310	Shale Blue	1130	Shale	2535
Lime & Shells	345	Lime & Shell	1175	Lime	2550
Lime	350	Shale	1210	Lime & Shells	2565
Shale	375	Lime	1215	Shale	2615
Lime	410	Shale	1222	Lime	2620
Sand	425	Lime	1242	Shale	2630
Shale	445	Shale	1245	Lime	2665
Red Rock	450	Red Rock	1250	Shale	2685
Lime	455	Lime	1260	Lime	2705
Shale	470	Shale	1300	Shale	2710
Lime	475	Shale Blue	1350	Red Rock	2715
Shale	490	Lime	1380	Shale	2737
Shale	500	Shale	1400	Lime	2746
Shale	510	Lime	1410	Water Sand H F W	2761
Shale	525	Shale	1455	Lime (5" P 3010)	2957
Red Rock	540	Lime	1505	Shale	3055
Lime	570	Shale	1510	Lime	3058
Shale	585	Sand	1515	Lime Sandy H F W	3061
Shale & Lime Shells	640	Lime	1565	Lime	3204
Lime	655	Shale	1575	Shale	3210
Shale	670	Lime	1615	Lime	3215
Lime	675	Shale	1640	Shale Gray	3220
Shale	695	Lime	1710	Shale Green	3220
Lime	720	Sand	1735	Lime	3270
Shale Black	725	Shale	1770	TOTAL DEPTH	
Lime	745	Lime	1815		
Shale	765	Shale	1825	FESTER & HARPER	
Lime Sandy	775	Lime	1835	By Mike Harper	

PLUGGING

Free Sand 24-2 U

BOOK PAGE-73 LINE-4-1

STATE OF KANSAS
JUN 10 1960
CONSERVATION