


WELL PLUGGING RECORD

Give All Information Completely
Make Required Affidavit
Mail or Deliver Report to:
Conservation Division
State Corporation Commission
211 No. Broadway
Wichita, Kansas

NORTH

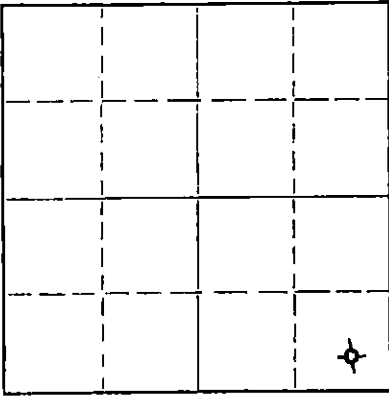

Locate well correctly on above
Section Plat

RUSSELL County, Sec. 12 Twp. 15S Rge. 11 (E) 11 (W)

Location as "NE/CNW/SW" or footage from lines SE SE SE

Lease Owner J. E. MORRIS AND L. E. PHILLIPS, JR.

Lease Name ZAMZLA Well No. 1

Office Address P. O. BOX 334, EL DORADO, KANSAS 67042

Character of Well (completed as Oil, Gas or Dry Hole) DRY HOLE

Date well completed 28 JULY 19 64

Application for plugging filed 28 JULY 19 64

Application for plugging approved 28 JULY 19 64

Plugging commenced 28 JULY 19 64

Plugging completed 28 JULY 19 64

Reason for abandonment of well or producing formation DRY HOLE

If a producing well is abandoned, date of last production NONE 19

Was permission obtained from the Conservation Division or its agents before plugging was commenced? YES

Name of Conservation Agent who supervised plugging of this well DONALD TRUAN

Producing formation NONE Depth to top Bottom Total Depth of Well 3713 RB Feet

Show depth and thickness of all water, oil and gas formations.

OIL, GAS OR WATER RECORDS

CASING RECORD

FORMATION	CONTENT	FROM	TO	SIZE	PUT IN	PULLED OUT
<u>SURFACE HOLE</u>	<u>WATER</u>	<u>SURFACE</u>	<u>260 RB</u>	<u>8 5/8" OD</u>	<u>254.52'</u>	<u>LEFT IN</u>
<u>(SEE ATTACHED LOG)</u>						

Describe in detail the manner in which the well was plugged, indicating where the mud fluid was placed and the method or methods used in introducing it into the hole. If cement or other plugs were used, state the character of same and depth placed, from feet to feet for each plug set.

FILLED HOLE WITH HEAVY DRILLING MUD TO 250', SET PLUG AND CEMENTED WITH 25 SACKS CEMENT,
FILLED HOLE WITH HEAVY DRILLING MUD TO 30', SET PLUG AND CEMENTED WITH 10 SACKS CEMENT, PUT
2 SACKS CEMENT IN RAT HOLE.

RECEIVED
STATE CORPORATION COMMISSION

JAN 22 1965

CONSERVATION DIVISION
Wichita, Kansas

1-22-65

(If additional description is necessary, use BACK of this sheet)
Name of Plugging Contractor REX & MORRIS DRILLING COMPANY
Address P. O. BOX 334, EL DORADO, KANSAS 67042

STATE OF KANSAS, COUNTY OF BUTLER, ss.
A. H. FISHER (employee of owner) or (owner or operator) of the above-described well, being first duly sworn on oath, says: That I have knowledge of the facts, statements, and matters herein contained and the log of the above-described well as filed and that the same are true and correct. So help me God.

(Signature) A. H. Fisher
P. O. BOX 334, EL DORADO, KANSAS

SUBSCRIBED AND SWORN TO before me this 21ST day of JANUARY, 19 64

My commission expires 8 AUGUST 1966

Elizabeth Deschner
ELIZABETH DESCHNER Notary Public.

15.167.00601.00.00

Z A M R Z L A # 1

J.E. Morris and L.E. Phillips, Jr.

Elevation 1750' RB
1745' GL

Total Depth: 3317' RB
Contractor: Rex & Morris
Commenced: 7-22-64
Completed: 7-28-64
Initial Prod.: D & A

Location: SE SE SE
Section 12-15S-11W
Russell County, Kansas

Casing Record:
8 5/8" OD @ 260' RB W/160 Sacks

FORMATION	DEPTH
Surface Hole	260'
Shale	370'
Anhydrite	420'
Shale and Lime	970'
Lime and Shale	1705'
Shale and Lime	2455'
Lime and Shale	2670'
Lime	2830'
Lime and Shale	2935'
Lime	3104'
Lime and Shale	3255'
Conglomerate Sand	3268'
Arbuckle Dolomite R.T.D.	3317'

I hereby certify the foregoing statements are true and correct to the best of my knowledge and belief.

Rex & Morris Drilling Company

By A.H. Fisher
A.H. Fisher

STATE OF KANSAS
COUNTY OF BUTLER, SS.

Subscribed and sworn to before me, a Notary Public, this 21st day of January, 1965.

Elizabeth Deschner
Elizabeth Deschner, Notary Public

My commission expires: August 8, 1966.

RECEIVED
STATE CORPORATION COMMISSION

JAN 22 1965

CONSERVATION DIVISION
Wichita, Kansas