


WELL PLUGGING RECORD

Give All Information Completely
Make Required Affidavit
Mail or Deliver Report to:
Conservation Division
State Corporation Commission
211 No. Broadway
Wichita, Kansas

NORTH

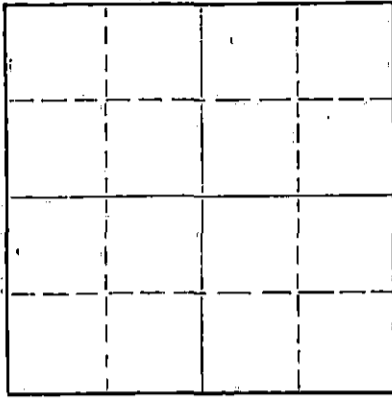

Locate well correctly on above
Section Plat

Russell County, Sec. 35 Twp. 14S Rge. 15W(E) (W)
Location as "NE/CNW/SW" or footage from lines NW SW SE
Lease Owner ALPINE OIL & ROYALTY CO., INC.
Lease Name Sam Hall Well No. 1
Office Address 800 Bitting Building, Wichita, Kansas
Character of Well (completed as Oil, Gas or Dry Hole) dry hole
Date well completed March 11, 1964 19
Application for plugging filed March 11, 1964 19
Application for plugging approved March 11, 1964 19
Plugging commenced March 11, 1964 19
Plugging completed March 11, 1964 at 11:00 P. M. 19
Reason for abandonment of well or producing formation non-productive in commercial quantities
If a producing well is abandoned, date of last production _____ 19
Was permission obtained from the Conservation Division or its agents before plugging was commenced? yes

Name of Conservation Agent who supervised plugging of this well Eldon Petty
Producing formation _____ Depth to top _____ Bottom _____ Total Depth of Well 3310 Feet
Show depth and thickness of all water, oil and gas formations.

OIL, GAS OR WATER RECORDS

CASING RECORD

FORMATION	CONTENT	FROM	TO	SIZE	PUT IN	PULLED OUT
				8 5/8"	280'	cemented

Describe in detail the manner in which the well was plugged, indicating where the mud fluid was placed and the method or methods used in introducing it into the hole. If cement or other plugs were used, state the character of same and depth placed, from _____ feet to _____ feet for each plug set.

Welded collar on surface pipe and Halliburton pumped 100 sacks cement down hole with one plug ahead of cement job - completed at 11:00 P. M.

RECEIVED
STATE CORPORATION COMMISSION

MAR 17 1964

CONSERVATION DIVISION
Wichita, Kansas

(If additional description is necessary, use BACK of this sheet)
Name of Plugging Contractor Quaker Drilling Co., Inc.
Address 800 Bitting Building, Wichita, Kansas

STATE OF Kansas, COUNTY OF Sedgwick, ss.
Dwight J. Wilson

(employee of owner) or (owner or operator) of the above-described well, being first duly sworn on oath, says: That I have knowledge of the facts, statements, and matters herein contained and the log of the above-described well as filed and that the same are true and correct. So help me God.

(Signature)

800 Bitting Building, Wichita, Kansas
(Address)

SUBSCRIBED AND SWORN TO before me this 16th day of March, 19 64

My commission expires August 10, 1965

Notary Public.

WELL LOG

ALPINE OIL & ROYALTY CO., INC.

Commenced: March 3, 1964

Contractor: Quaker Drilling Co., Inc.

Completed: March 11, 1964

Alpine's No. 1 Sam Hall
NW SW SE Sec. 35-14S-15W
Russell County, Kansas

Elevation: 1799 K.B.

Production: D & A

Casing Record

8 5/8 inch casing set at 280 feet with 200 sacks of cement

(Figures Indicate the Bottom of the Formations)

<u>FORMATION</u>	<u>DEPTH</u>	<u>FORMATION TOPS</u>	
Shale and Sand	110	Heebner	2944 -1145
Grey and Blue Shale	185	Toronto	2962 -1163
Shale and Shells	280	Lansing	3003 -1204
Shale	370	Base Kansas City	3233 -1434
Sand	450	Arbuckle	3268 -1469
Shale and Red Bed	829	Rotary Total	
Anhydrite	864	Depth	3310 -1511
Shale and Shells	1440		
Lime and Shale	2400		
Shale	2515		
Shale and Lime	2772		
Lime	2870		
Lime and Shale	2950		
Lime	3085		
Lime and Shale	3310		

RECEIVED
STATE CORPORATION COMMISSION

MAR 17 1964

CONSERVATION DIVISION
Wichita, Kansas

We hereby certify the foregoing to be a true and correct copy of the driller's log of the test drilled in the NW SW SE Section 35, Township 14 South, Range 15 West, Russell County, Kansas.

QUAKER DRILLING CO., INC.

By: Dwight J. Wilson
Dwight J. Wilson

SUBSCRIBED AND SWORN TO before me a Notary Public this 16th day of March, 1964.

Virginia Mundell
Virginia Mundell, Notary Public

MY COMMISSION EXPIRES:
August 10, 1965.