

STATE OF KANSAS
STATE CORPORATION COMMISSION


Form CP-4

Give All Information Completely
Make Required Affidavit
Mail or Deliver Report to:
Conservation Division
State Corporation Commission
212 No. Market
Wichita, Kansas

WELL PLUGGING RECORD

Kingman County. Sec. 3 Twp. 30S Rge. 9 (X) (W)
Location as "NE/CNW/SW" or footage from lines C SW/4, NE/4
Lease Owner Pan American Petroleum Corporation
Lease Name Twyman Well No. _____
Office Address Box 432, Liberal, Kansas
Character of Well (completed as Oil, Gas or Dry Hole) Gas
Date well completed 7-29 19 65
Application for plugging filed 2-8 19 68
Application for plugging approved 2-9 19 68
Plugging commenced 2-19 19 68
Plugging completed 2-23 19 68
Reason for abandonment of well or producing formation Economically Depleted
If a producing well is abandoned, date of last production January 1968
Was permission obtained from the Conservation Division or its agents before plugging was commenced? Yes

NORTH

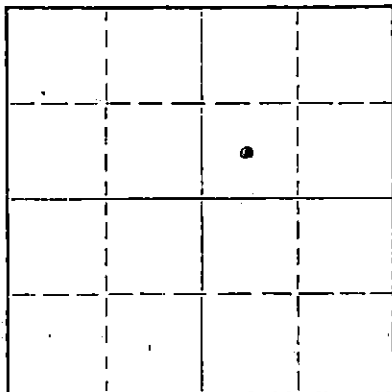

Locate well correctly on above Section Plat

Name of Conservation Agent who supervised plugging of this well A. Elving
Producing formation Mississippian Depth to top 4215 Bottom 4225 Total Depth of Well 4290 Feet
Show depth and thickness of all water, oil and gas formations.

OIL, GAS OR WATER RECORDS

CASING RECORD

FORMATION	CONTENT	FROM	TO	SIZE	PUT IN	PULLED OUT
Mississippian	Gas - Depleted	4215	4225	8-5/8	242	None
				4-1/2	4272	2704

Describe in detail the manner in which the well was plugged, indicating where the mud fluid was placed and the method or methods used in introducing it into the hole. If cement or other plugs were used, state the character of same and depth placed, from _____ feet to _____ feet for each plug set.

Lane Wells Bridge Plug set at 3850'

2 Sacks Cement	3850 - 3802
Mud & Water	3802 - 240
Rock Bridge	240 - 230
25 Sacks Cement	230 - 175
Mud	175 - 40
10 Sacks Cement	40 - Zero

RECEIVED
STATE CORPORATION COMMISSION
FEB 28 1968
CONSERVATION DIVISION
Wichita, Kansas
2-28-68

(If additional description is necessary, use BACK of this sheet)
Name of Plugging Contractor Knight Casing Pulling Company, Inc.
Address Chase, Kansas

STATE OF Kansas, COUNTY OF Seward, ss.
I, E. C. Woodall (employee of owner) or (owner) of the above-described well, being first duly sworn on oath, says: That I have knowledge of the facts, statements, and matters herein contained and the log of the above-described well as filed and that the same are true and correct. So help me God.

(Signature) E. C. Woodall
Box 432, Liberal, Kansas
(Address)

Subscribed and sworn to before me this 27 day of February 1968
February 11, 1972
R. B. Banks Notary Public.



KENNETH RUPP - Operator

SIERRA PETROLEUM CO., INC. - Contractor

TWYMAN #1
C SW NE
Sec. 3-303-9W
Kingman County, Kansas

T. D.: 4288'
Elev.: 1641' K.B.

Commenced: 7-7-65
Completed: 7-13-65

Casing:

8-5/8" Set at 242'
4-1/2" Set at 4272'

Cement:

with 175 sx. w/ GL-3
with 150 sx. Pozmix

FORMATION

DEPTH

Surface Clay & Sand
Redbed
Redbed, Shale & Salt
Shale & Lime
Lime
Chert
Lime

80
660
1325
3555
4235
4281
4288

TD BY ELECTRIC LOG 4290'

RECEIVED
STATE CORPORATION COMMISSION
FEB 28 1968
CONSERVATION DIVISION
Wichita, Kansas

STATE OF KANSAS }
COUNTY OF RUSSELL } ss:

I hereby certify that the above information is true and correct to the best of my knowledge.

G. A. Hall
G. A. Hall, Prod. Supt.

Subscribed and sworn to before me this 17th day of July, 1965.

[Signature]
Notary Public

My commission expires: 10-17-67

