


WELL PLUGGING RECORD

Give All Information Completely  
Make Required Affidavit  
Mail or Deliver Report to:  
Conservation Division  
State Corporation Commission  
211 No. Broadway  
Wichita, Kansas

NORTH

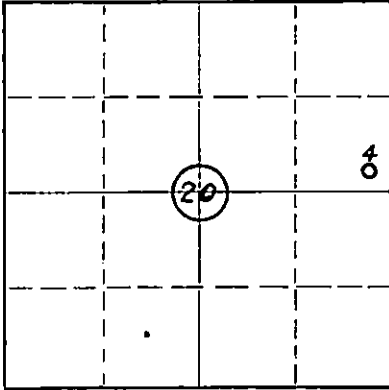

Locate well correctly on above  
Section Plat

Barton County, Sec. 20 Twp. 16S Rge. 11W (E) (W)

Location as "NE/CNW/SW" or footage from lines 330' f/So. & 330' f/East of NE/4

Lease Owner Sinclair Oil & Gas Company

Lease Name Joe Prusa

Well No. 4

Office Address P. O. Box 521 - Tulsa 2, Oklahoma 74102

Character of Well (completed as Oil, Gas or Dry Hole) Oil Well

Date well completed March 3, 1964

Application for plugging filed February 12 1964

Application for plugging approved February 13 1964

Plugging commenced February 28 1964

Plugging completed March 3, 1964

Reason for abandonment of well or producing formation Depleted

If a producing well is abandoned, date of last production February 1963

Was permission obtained from the Conservation Division or its agents before plugging was commenced? Yes

Name of Conservation Agent who supervised plugging of this well Mr. Donald Truan

Producing formation Arbuckle Depth to top 3290 Bottom 3298 Total Depth of Well 3298 Feet

Show depth and thickness of all water, oil and gas formations.

OIL, GAS OR WATER RECORDS

CASING RECORD

FORMATION	CONTENT	FROM	TO	SIZE	PUT IN	PULLED OUT
Arbuckle	(open hole)	3290	3298 TD	10 3/4"	103'	None Pulled
				7"	3290'	2326'

Describe in detail the manner in which the well was plugged, indicating where the mud fluid was placed and the method or methods used in introducing it into the hole. If cement or other plugs were used, state the character of same and depth placed, from \_\_\_\_\_ feet to \_\_\_\_\_ feet for each plug set.

Spotted sand from 3298' to 3280', with 5 sacks on top from 3280' to 3256'. Mudded hole from 3256' to 240'. Spotted 30 sacks cement from 240' to 125'. Mudded from 125' to 40'. Set 10 sacks cement rock bridge from 40' to 30'. Capped with 10 sacks cement. Completed P&A oil well 3/3/64, under direction of Mr. Donald Truan, State Plugging Agent.

RECEIVED  
STATE CORPORATION COMMISSION

MAR 6 1964  
3-6-64  
CONSERVATION DIVISION  
Wichita, Kansas

(If additional description is necessary, use BACK of this sheet)

Name of Plugging Contractor Knight Casing Pulling Company

Address P. O. Box 304 - Chase, Kansas 67521

STATE OF Kansas, COUNTY OF Barton, ss.

J. F. Donham (District Superintendent) (employee of owner) or (owner or operator) of the above-described well, being first duly sworn on oath, says: That I have knowledge of the facts, statements, and matters herein contained and the log of the above-described well as filed and that the same are true and correct. So help me God.

(Signature)

Route # 1 - Great Bend, Kansas 67530  
(Address)

SUBSCRIBED AND SWORN to before me this 5 day of March, 1964

My commission expires July 12, 1967

Fred E. Wobornik  
Notary Public.



JOE PRIMA WELLS #1

DATE: \_\_\_\_\_ TIME: \_\_\_\_\_

DESCRIPTION	DEPTH
Shale-shells	100
Red-bed & card shells	395
Shale-red bed	625
Shale-Shells	730
Argyrite	750
Shale-Shells	1200
Salt-shale	1250
Shale	1280
Lime	1480
Shale-shells	1500
Broken Lime	1530
Shale-Lime	1730
Sandy Lime	1795
Shale-lime shells	1845
Shale-Shells	1850
Lime-shale	1900
Lime	1960
Shale-Lime shells	2025
Lime	2120
Shale	2140
Shale-shells	2390
Shale-Lime	2485
Shale-Lime shells	2595
Lime Shale	2705
Lime	2773
Sand	2780
Lime	2915
Shale	2987
Lime Top K.G. 3000'	3080
Shale-Lime	3089
Soft Lime	3095
Lime	3185
Hard Lime	3188
Soft lime	3195
Lime	3230
Shale - Lime Top Arbuckle 3290'	3276
Lime	3298 TD

slope test at 250' and at every 250' hereafter to 3,000' a.l. D.K.

odor oil & gas 3040-45

show oil

h-28-52 State Physical Test, 2h hrs. 19 bbls. oil, 92% water.

**RECEIVED**  
STATE CORPORATION COMMISSION

MAR 6 1964

CONSERVATION DIVISION  
Wichita, Kansas