


Give All Information Completely
Make Required Affidavit
Mail or Deliver Report to:
Conservation Division
State Corporation Commission
800 Bitting Building
Wichita, Kansas

WELL PLUGGING RECORD

NORTH

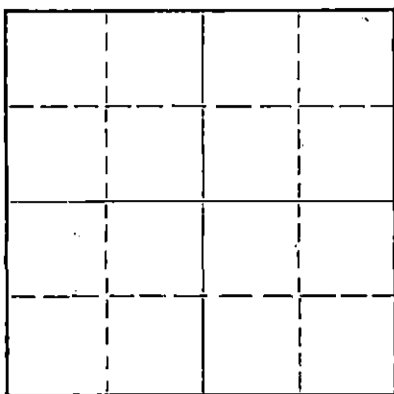

Locate well correctly on above
Section Plat

Barton County. Sec. 20 Twp. 16 Rge. 11 (E) W (W)
Location as "NE/CNW/SW" or footage from lines SE SW SW
Lease Owner Clark Knight Drilling Company
Lease Name Esfeld Well No. 1
Office Address Box 162 - Great Bend, Kansas
Character of Well (completed as Oil, Gas or Dry Hole) Dry Hole
Date well completed 8-3 19 54
Application for plugging filed 8-4 19 54
Application for plugging approved 8-4 19 54
Plugging commenced 8-4 19 54
Plugging completed 8-4 19 54
Reason for abandonment of well or producing formation Dry Hole

If a producing well is abandoned, date of last production _____ 19____
Was permission obtained from the Conservation Division or its agents before plugging was commenced? Yes

Name of Conservation Agent who supervised plugging of this well W. H. Horner
Producing formation _____ Depth to top _____ Bottom _____ Total Depth of Well _____ Feet
Show depth and thickness of all water, oil and gas formations.

OIL, GAS OR WATER RECORDS

CASING RECORD

FORMATION	CONTENT	FROM	TO	SIZE	PUT IN	PULLED OUT
		0	270	8 5/8	270'	-0-

Describe in detail the manner in which the well was plugged, indicating where the mud fluid was placed and the method or methods used in introducing it into the hole. If cement or other plugs were used, state the character of same and depth placed, from _____ feet to _____ feet for each plug set.

Filled hole with heavy mud from 3010' to 260'. Pushed 1/3 sack of hulls to 260'. Displaced 20 sacks of cement through drill pipe with Halliburton plug. Filled hole with mud to 35'. Pushed 1/3 sack of hulls to 35'. Displaced 10 sacks of cement through drill pipe. Cement in cellar.

(If additional description is necessary, use BACK of this sheet)

Name of Plugging Contractor Clark Knight Drilling Company
Address Box 162 - Great Bend, Kansas

STATE OF _____, COUNTY OF _____, ss. _____ (employee of owner) or (owner or operator) of the above-described well, being first duly sworn on oath, says: That I have knowledge of the facts, statements, and matters herein contained and the log of the above-described well as filed and that the same are true and correct. So help me God.

(Signature) [Signature]

(Address) _____

SUBSCRIBED AND SWORN TO before me this 15 day of Sept, 1954

My commission expires Aug. 26, 1958

PLUGGING
FILED SEC 20 T 16 R 11W
BOOK PAGE 54 LINE 40

Notary Public.
STATE CORPORATION COMMISSION
SEP 16 1954
9-16-54
CONSERVATION DIVISION
Wichita, Kansas

WELL LOG

15-009-06766-0000

CLARK KNIGHT DRILLING COMPANY

LEASE: ESFELD
WELL NO.: 1

SE SW SW
SECTION 20-16-11W
BARTON COUNTY,
KANSAS

TOTAL DEPTH: 3010 R.B.
COMM: 7-28-54 COMP: 8-3-54
CONTRACTOR: CLARK KNIGHT DRILLING COMPANY
ROTARY: 0 - 3010'

ELEVATION:
PRODUCTION: D & A

CASING RECORD: 8 5/8" set @ 270' cemented w/140
sacks bulk cement, circulated.

FIGURES INDICATE BOTTOM OF FORMATION

Clay	135
Shale & Shells	330
Sand	360
Red Bed Shells	558
Shale	610
Anhydrite	850
Shale & Shells	1425
Sand & Lime	1465
Lime & Shale	1805
Lime	1895
Lime & Shale	2160
Shale	2490
Shale & Lime	2987
Shale	3010

We hereby certify this to be a correct and accurate log of the above described well as shown on the daily drilling reports.

CLARK KNIGHT DRILLING COMPANY

By L. C. Knight

Subscribed and sworn to before me this 15 day of Sept, 1954.

H. W. Keith
Notary Public

My commission expires Aug. 26, 1954

RECEIVED
STATE CORPORATION COMMISSION

15 1954

VISIT:

PLUGGING
FILE SEC 20 T 16 R 11W
BOOK PAGE 54 LINE 40