


15-057-20325-0000

WELL PLUGGING RECORD

Give All Information Completely
 Make Required Affidavit

COUNTY Ford SEC. 22 TWP. 25S RGE. 22 E/W
 Location as in quarters or footage from lines:
C SE NW

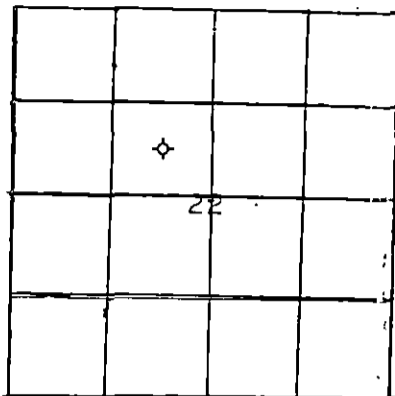

Locate Well
 correctly on above
 Section Platt.

Lease Owner Powderhorn Petroleum, Inc.
 Lease Name Scheve Well No. 1
 Office Address 910 16th St., 1100 Univeristy Bldg., Denver
 Character of Well (Completed as Oil, ^{CO 80202} Gas or Dry Hole): dry hole
 Date Well Completed June 26, 1983
 Application for plugging filed June 26, 1983
 Plugging commenced June 26, 1983
 Plugging completed June 26, 1983
 Reason for abandonment of well or producing formation dry hole

Was permission obtained from the Conservation Division or it's
 Agent's before plugging was commenced? yes

Name of Conservation Agent who supervised plugging of this well J. H. Metz
 Producing formation _____ Depth to top _____ bottom T.D. 4,910'

Show depth and thickness of all water, oil and gas formations.

OIL, GAS OR WATER RECORDS

Casing Record

Formation	Content	From	To	Size	Put in	Pulled Out.
				8-5/8"	520'	

Describe in detail the manner in which the well was plugged, indicating where the mud
 fluid was placed and the method or methods used in introducing it into the hold. If cement
 or other plugs were used, state the character of same and depth placed, from _____ feet
 to _____ feet for each plug set.

Mud to 1,550', 60 sx cement
 mud to 570', 15 sx cement
 mud to 40', plug, 10 sx cement
 10 sx in rathole

(If additional description is necessary, use BACK of this sheet)

Name of Plugging Contractor _____

STATE OF KANSAS COUNTY OF SEDGWICK, ss.
Donald E. Hunt (employee of owner) ~~owner or operator~~ of the
 above-described well, being first duly sworn on oath, says: That I have knowledge of the
 facts, statements, and matters herein contained and the log of the above-described well as
 filed and that the same are true and correct. So help me God.

(Signature) Donald E. Hunt
 Suite 250, 200 W. Douglas
 Wichita, (Address) Kansas 67202

SUBSCRIBED AND SWORN TO before me this 28th day of June, 1983

Kathleen Greger
 Notary Public.

My Commission expires: January 20, 1985

JUL 1 1983 7-11-83