


STATE OF KANSAS
STATE CORPORATION COMMISSION

WELL PLUGGING RECORD

Give All Information Completely
Make Required Affidavit
Mail or Deliver Report to
Conservation Division
State Corporation Comm.
245 North Water
Wichita, KS 67202

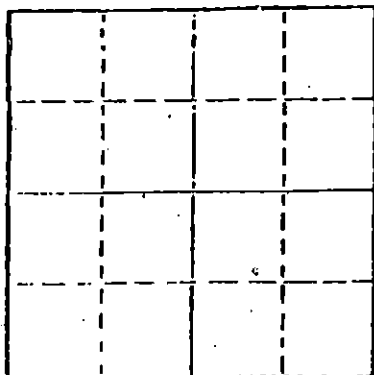

Locate well correctly on above
Section Plat

Hamilton County, Sec. 2 Twp. 22S Rge. 42 XE/W
Location as "NE/CNW $\frac{1}{4}$ SW $\frac{1}{4}$ " or footage from lines
C SE
Lease Owner Dome Petroleum Corp.
Lease Name Lewis Well No. 1
Office Address Suite 1500, 1600 Broadway, Denver, Colo.
Character of Well (Completed as Oil, Gas or Dry Hole) 80202

Date Well completed 2-20 1979
Application for plugging filed 2-20 1979
Application for plugging approved 2-20 1979
Plugging commenced 2-20 1979
Plugging completed 2-20 1979

Reason for abandonment of well or producing formation
no commercial quantities of oil or gas encountered

If a producing well is abandoned, date of last production
-- 19

Was permission obtained from the Conservation Division or
its agents before plugging was commenced? yes

Name of Conservation Agent who supervised plugging of this well Gilbert Balthazor
Producing formation Depth to top Bottom Total Depth of Well 2805
Show depth and thickness of all water, oil and gas formations.

OIL, GAS OR WATER RECORDS

CASING RECORD

FORMATION	CONTENT	FROM	TO	SIZE	PUT IN	PULLED OUT
surface hole	shale	surf	363'	8-5/8"	353'	none

Describe in detail the manner in which the well was plugged, indicating where the mud fluid
was placed and the method or methods used in introducing it into the hold. If cement or other
plugs were used, state the character of same and depth placed, from feet to
feet for each plug set.

Fluid to 2800', plug, 35 sx
Fluid to 360', plug, 35 sx
Fluid to 40', plug, 10 sx
5 sx in rat hole

2-27-79

RECEIVED
STATE CORPORATION COMMISSION

FEB 27 1979

(If additional description is necessary, use BACK of this sheet)
Name of Plugging Contractor D N B DRILLING, INC.
515 R. H. Garvey Building
Wichita, Kansas

STATE OF Kansas COUNTY OF Sedgwick, ss.
Ella Priess (employee of owner) or (owner or operator)
of the above-described well, being first duly sworn on oath, says: That I have knowledge of
the facts, statements, and matters herein contained and the log of the above-described well
as filed and that the same are true and correct. So help me God.

(Signature) Ella Priess

Suite 515, R. H. Garvey Bldg., Wichita, Ks. 67202
(Address)

SUBSCRIBED AND SWORN TO before me this 21st day of February, 1979

My commission expires April 30, 1979

Dorothy L. Schmidt
Dorothy L. Schmidt Notary Public.

DOROTHY L. SCHMIDT
STATE NOTARY PUBLIC
Sedgwick County, Kansas
My Appt. Exp. April 30, 1979

DRILLER'S LOG

DOME PETROLEUM CORP.
No. 1 Lewis
C SE Sec. 2-22S-42W
Hamilton Co., Ks.

Commenced: 2-15-79
Completed: 2-20-79

Surface Casing: 353' of 8-5/8"
cmtd w/300 sx Class H, 3% cc
2-16-79

FORMATIONDEPTH

Surface Hole	0 - 363
Shale	363 - 760
Shale & Sand	760 - 1335
Shale	1335 - 1635
Red Bed, Shale & Salt Streaks	1635 - 2200
Shale	2200 - 2269
Anhydrite	2269 - 2287
Shale, Sand Streaks	2287 - 2565
Shale & Sand	2565 - 2780
Shale	2780 - 2805 RTD

I do hereby certify that the foregoing statements are true and correct to the best of my knowledge and belief.

D N B DRILLING, INC.

Ella Priess

Ella Priess

STATE OF KANSAS: ss:

Subscribed and sworn to before me this 22nd day of February, 1979.

Dorothy L. Schmidt
Dorothy L. Schmidt, Notary Public

DOROTHY L. SCHMIDT
STATE NOTARY PUBLIC
Sedgwick County, Kansas
My Appt. Exp. April 30, 1979

RECEIVED
STATE CORPORATION COMMISSION

FEB 27 1979

CONSERVATION DIVISION
Wichita, Kansas