

STATE OF KANSAS
STATE CORPORATION COMMISSION

WELL PLUGGING RECORD

Give All Information Completely
Make Required Affidavit
Mail or Deliver Report to:
Conservation Division
State Corporation Commission
800 Bitting Building
Wichita, Kansas

OR

FORMATION PLUGGING RECORD

Strike out upper line
when reporting plug-
ging of formations.

Reno County. Sec. 20 Twp. 24 Rge. 4 (E) (W)

Location as "NE 1/4 NW 1/4 SW 1/4" or footage from lines. NW SW SW

Lease Owner Bert Self

Lease Name Tucker "B" Well No. 21

Office Address 419 East 6'th, Hutchinson, Kansas

Character of Well (completed as Oil, Gas or Dry Hole) Abandoned Oil Well

Date well completed 19. 46

Application for plugging filed May 4, 19. 46

Application for plugging approved May 16, 19. 46


Plugging commenced May 15, 19. 46

Plugging completed May 15, 19. 46

Reason for abandonment of well or producing formation Oil depleted

If a producing well is abandoned, date of last production 19. 46

Was permission obtained from the Conservation Division or its agents before plugging was com-
menced? Yes

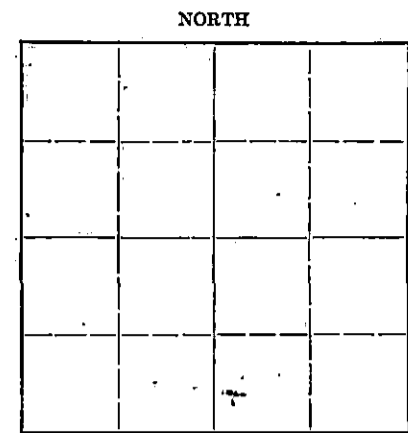

Locate well correctly on above
Section Plat

Name of Conservation Agent who supervised plugging of this well Ruel Durkee

Producing formation Depth to top Bottom Total Depth of Well 3369 Feet

Show depth and thickness of all water, oil and gas formations.

OIL, GAS OR WATER RECORDS

CASING RECORD

Formation	Content	From	To	Size	Put In	Pulled Out

Describe in detail the manner in which the well was plugged, indicating where the mud fluid was placed and the method or methods used in introducing it into the hole. If cement or other plugs were used, state the character of same and depth placed, from feet to feet for each plug set.

Hole made solid at 3350 feet and 6
sacks of cement dumped at 3350 feet
Hole made solid at 350 feet and 25
sacks of cement dumped at 350 feet.
8 sacks of cement dumped at top of
surface pipe.
The intervals between above plugs
were mudded with heavy mud.

STATE CORPORATION COMMISSION
WELL PLUGGING RECORD
-1947

9-8-47

(If additional description is necessary, use BACK of this sheet)

Correspondence regarding this well should be addressed to Bert Self

Address 419 East 6'th, Hutchinson, Kansas

STATE OF Kansas, COUNTY OF McPherson, ss.

(employee of owner) or (owner or operator) of the above-described well,
being first duly sworn on oath, says: That I have knowledge of the facts, statements, and matters herein contained and the log of the above-
described well as filed and that the same are true and correct. So help me God.

(Signature) Bert Self

(Address)

SUBSCRIBED AND SWORN to before me this 6 day of September, 19. 47

Victor C. Gensdorf
Notary Public.

My Commission Expires May 28, 1951

PLUGGING
FILE SEC 20 T 24 R 4W
BOOK PAGE 54 LINE 31