

15.167.00385.00.00

WELL PLUGGING RECORD

OR

FORMATION PLUGGING RECORD

Strike out upper line when reporting plugging of formations.


Russell County. Sec. 26 Twp. 15 Rge. 12 (W)

Location as "NE $\frac{1}{4}$ NW $\frac{1}{4}$ SW $\frac{1}{4}$ " or footage from lines NW NE NW
 Lease Owner Sunray Oil Corporation
 Lease Name Staudinger Well No. 1
 Office Address Box 195, Great Bend, Kansas
 Character of Well (completed as Oil, Gas or Dry Hole) Dry Hole
 Date well completed 19
 Application for plugging filed May 2 1949
 Application for plugging approved May 2 1949
 Plugging commenced April 28 1949
 Plugging completed April 28 1949
 Reason for abandonment of well or producing formation Dry Hole

If a producing well is abandoned, date of last production 19
 Was permission obtained from the Conservation Division or its agents before plugging was commenced? Yes

STATE OF KANSAS
 STATE CORPORATION COMMISSION
 Give All Information Completely
 Make Required Affidavit
 Mail or Deliver Report to:
 Conservation Division
 State Corporation Commission
 500 Bitting Building
 Wichita, Kansas

NORTH

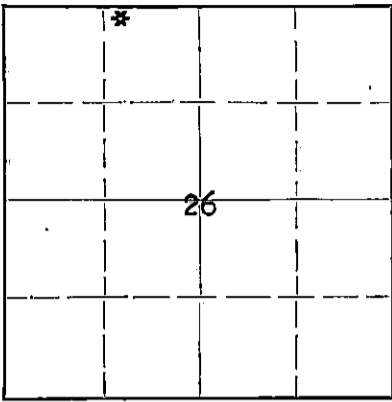

Locate well correctly on above Section Plat

Name of Conservation Agent who supervised plugging of this well C. D. Stough
 Producing formation Depth to top Bottom Total Depth of Well 3304 Feet
 Show depth and thickness of all water, oil and gas formations.

OIL, GAS OR WATER RECORDS

CASING RECORD

Formation	Content	From	To	Size	Put In	Pulled Out
Lsg.	Water	2994	3002	8-5/8"	330'	None
Arbuckle	Water	3284	3304			

Describe in detail the manner in which the well was plugged, indicating where the mud fluid was placed and the method or methods used in introducing it into the hole. If cement or other plugs were used, state the character of same and depth placed, from feet to feet for each plug set.

Plug at bottom of surface pipe cemented w/15 sax. Filled hole w/mud to 30'
 Put plug at 30'. Capped w/10 sax cement.

5-6-49

RECEIVED
 Conservation Div.
 MAY 6 - 1949
 STATE CORPORATION
 COMMISSION
 KANSAS

(If additional description is necessary, use BACK of this sheet)

Correspondence regarding this well should be addressed to Sunray Oil Corporation
 Address Box 195, Great Bend, Kansas

STATE OF KANSAS, COUNTY OF BARTON, ss.

G. D. Strother (employee of owner) of the above-described well, being first duly sworn on oath, says: That I have knowledge of the facts, statements, and matters herein contained and the log of the above-described well as filed and that the same are true and correct. So help me God.

(Signature) G. D. Strother Engineer

Box 195, Great Bend, Kansas (Address)

SUBSCRIBED AND SWORN to before me this 5 day of May, 1949

M. Scott
 Notary Public

My commission expires April 19, 1952.

22-2626 2-48-15M

PLUGGING
 FILE SEC 26 T 15 R 12
 PAGE 94 LINE 6

15. 167. 00385. 00. 00

Standinger #1

NW NE NW
Section 26-15-12
Russell County, Kansas

Started: 4/15/49
Contractor: R. V. Rine Drilling Co.

Finished: 4/28/49

Log

Shale	0- 70	
Shale, shells	70- 330	8-5/8" w/ 225 @ 330'
Hard sand	330- 340	
Shale, shells	340- 437	
Rod bed	437- 705	
Anhydrite	705- 740	
Shale, shells	740-1145	
Salt, shells	1145-1295	
Shale, salt, shells	1295-1530	
Shale, lime	1530-1675	
Lime	1675-2200	
Shale	2200-2430	
Shale, lime	2430-2715	
Lime	2715-3278	
Conglomerate	3278-3300	
Lime	3300-3304	T.D. 3304'

D & A

State of Kansas)
County of Sedgwick) ss

I, E. H. Sloyer, do hereby certify that the above is a true and accurate log of the Standinger Well No. 1 located in the NW/4 of the NE/4 of the NW/4 of Section 26-15-12, Russell County, Kansas.

E. H. Sloyer
Secretary

My commission expires Dec. 29, 1952

R. M. Green
Notary Public

Sworn to and subscribed before me this 3rd day of May, 1949.

RECEIVED

Conservation Div.

MAY 6 - 1949

STATE CORPORATION
COMMISSION
KANSAS

PLUGGING
FILE SEC 26-T-15-R-172
BOOK PAGE 94 LINE 6