


Give All Information Completely  
Make Required Affidavit  
Mail or Deliver Report to:  
Conservation Division  
State Corporation Commission  
800 Biting Building  
Wichita, Kansas

WELL PLUGGING RECORD

NORTH

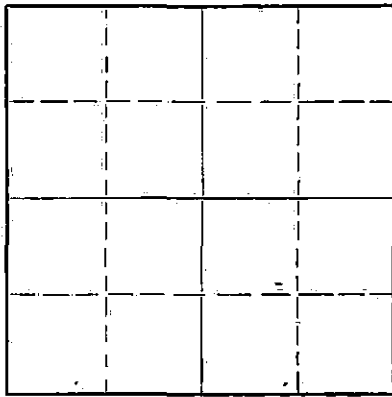

Locate well correctly on above  
Section Flat

Russell County, Sec. 23 Twp. 15S Rge. (E) 12 (W)  
Location as "NE/CNW/SW" or footage from lines C-NW-SW-NE  
Lease Owner Sunray Oil Corporation  
Lease Name Heinze Well No. 1  
Office Address Box 195, Great Bend, Kansas  
Character of Well (completed as Oil, Gas or Dry Hole) Dry Hole  
Date well completed May 9 19 53  
Application for plugging filed May 11 19 53  
Application for plugging approved May 12 19 53  
Plugging commenced May 9 19 53  
Plugging completed May 9 19 53  
Reason for abandonment of well or producing formation Dry Hole

If a producing well is abandoned, date of last production 19  
Was permission obtained from the Conservation Division or its agents before plugging was commenced? Yes

Name of Conservation Agent who supervised plugging of this well C. D. Strough, Box 207, Great Bend, Kansas  
Producing formation Depth to top Bottom Total Depth of Well 3260 Feet  
Show depth and thickness of all water, oil and gas formations.

OIL, GAS OR WATER RECORDS

CASING RECORD

FORMATION	CONTENT	FROM	TO	SIZE	PUT IN	PULLED OUT
Tarkio	Water	2334	2360	8 5/8	688'	none
Topeka	Water	2777	2810			
Heebner	Water	2838	2842			
Toronto	Gas	2860	2866			
Douglas	Gas	2884	2891			
Lansing-Kansas City	Water	2942	3129			
Conglomerate	Water	3224	3240			
Arbuckle	Water	3249	3258	/		

Describe in detail the manner in which the well was plugged, indicating where the mud fluid was placed and the method or methods used in introducing it into the hole. If cement or other plugs were used, state the character of same and depth placed, from feet to feet for each plug set.

Mudded hole from 3260' to 300', and ran 40 sax cement. Mudded hole to 30' and ran 10 sax cement. Hole plugged and abandoned under supervision of Corporation Commission Supervisor.

Well log attached.

(If additional description is necessary, use BACK of this sheet)

Name of Plugging Contractor Stickle Drilling Company  
Address Philtower Building, Tulsa, Oklahoma

STATE OF Kansas, COUNTY OF Barton, SS.  
Robert K. Crouch (employee of owner) or ~~owner/operator~~ of the above-described well, being first duly sworn on oath, says: That I have knowledge of the facts, statements, and matters herein contained and the log of the above-described well as filed and that the same are true and correct. So help me God?

(Signature) Robert K. Crouch  
Box 195, Great Bend, Kansas  
(Address)

SUBSCRIBED AND SWORN to before me this 18 day of May, 19 53

My commission expires December 24, 1956

PLUGGING  
FILE SEC-23T-15-R-124  
BOOK PAGE 100 LINE 22

24-2678-S 2-52-20M

RECEIVED  
MAY 19 1953  
CONSERVATION DIVISION  
Wichita, Kansas

Notary Public.

5-19-53

15 167 000 67 00 00

Sunray Oil Corporation  
Tulsa, Oklahoma

Tulsa, Oklahoma  
May 11, 1953

CONTRACTOR: Stickle Drilling Company  
Drilling Commenced: April 27, 1953  
Drilling Completed: May 9, 1953

Heinze #1 NW-SW-NW-  
Sec. 23-15S-12W,  
Russell County, Kansas.

DRILLERS LOG

Clay & Shale	0-150
Shale & Shells - Iron	150-370
Shale and Iron	370-595
Shale-Iron-Sand and Shells	595-677
Anhydrite	677-708
Shale and Shells	708-1345
Lime & Shale	1345-2280
Shale and Lime	2280-2460
Shale and Shells	2460-2600
Shale and Lime	2600-2670
Lime and Shale	2670-2810
Lime	2810-2814
Lime and Shale	2814-2887
Sandy Shale and Lime	2887-2950
Lime	2950-3260 TD

I, Frank E. Stickle, hereby certify the above to be a true and complete drillers log of The Texas Company's Heinze #1 NW-SW-NW-Section 23-15S-12W, Russell County, Kansas.

Frank E. Stickle  
Frank E. Stickle

Edward Fackel  
Notary Public

June 16, 1953  
My Commission Expires

**PLUGGING**  
FILE SEC 23-T 15S-R 12W  
BOOK PAGE 100 LINE 22