15.167.00536.00.00

STATE OF KANSAS
STATE CORPORATION COMMISSION

Give All Information Completely
Make Required Affidavits
Mail or Deliver Report to:
Conservation Division
State Corporation Commission
800 Bitting Building
Wichita, Kansas


WELL PLUGGING RECORD

OR

FORMATION PLUGGING RECORD

Strike out upper line when reporting plugging off formations.

NORTH

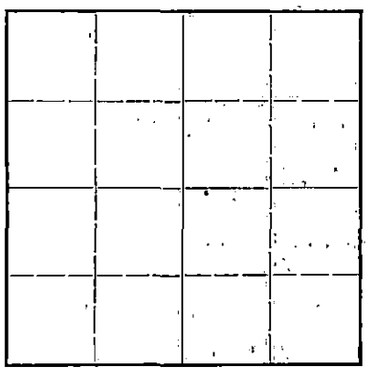

Locate well correctly on above Section Plat

Russell County. Sec. 5 Twp. 15 Rge. 14 (E) (W)

Location as "NE¼NW¼SW¼" or footage from lines SE

Lease Owner John Lindas

Lease Name Driscoll Well No. 1

Office Address Union Nat'l Bank Bldg., Wichita, Ks.

Character of Well (completed as Oil, Gas or Dry Hole) Dry Hole

Date well completed 12/19/45 19

Application for plugging filed 12/18/45 19

Application for plugging approved 12/18/45 19

Plugging commenced 12/18/45 19

Plugging completed 12/18/45 19

Reason for abandonment of well or producing formation Dry Hole

If a producing well is abandoned, date of last production 19

Was permission obtained from the Conservation Division or its agents before plugging was commenced? Yes

Name of Conservation Agent who supervised plugging of this well H. W. Kerr

Producing formation Depth to top Bottom Total Depth of Well 3240 Feet

Show depth and thickness of all water, oil and gas formations.

OIL, GAS OR WATER RECORDS — CASING RECORD

Formation	Content	From	To	Size	Put In	Pulled Out
				10 3/4"	297'	None

Describe in detail the manner in which the well was plugged, indicating where the mud fluid was placed and the method or methods used in introducing it into the hold. If cement or other plugs were used, state the character of same and depth placed, from feet to feet for each plug set.

Plug hole - plug and 15 sacks cement at 275' - plug and 10 sacks to top of hole.

PLUGGING
FILE 5-15-14W
BOOK PAGE 37 LINE 18

(If additional description is necessary, use BACK of this sheet)

Correspondence regarding this well should be addressed to John Lindas

Address John Lindas, Union Nat'l Bank Bldg., Wichita

STATE OF Kansas, COUNTY OF Russell, ss.

C. L. Roberts (employee of owner) or (owner or operator) of the above-described well, being first duly sworn on oath, says: That I have knowledge of the facts, statements, and matters herein contained and the log of the above-described well as filed and that the same are true and correct. So help me God.

(Signature) C. L. Roberts 12-26-45

Russell, Kans. (Address)

SUBSCRIBED AND SWORN TO before me this 24th day of December, 1945

Oscar Ostrum Notary Public.

My commission expires Oct. 10-1946

STATE CORPORATION COMMISSION DEC 26 1945 CONSERVATION DIVISION

20-1300-s 11-43—10M

15-167-00536-00-00

John Lindas
Driscoll #1

Sec. 5 Twp. 15 Rge. 14
County: Russell, Kansas

Total Depth: 3240'
Comm: 11/29/45 Comp: 12/19/45

Casing
14 Jts 10 3/4" Set at 295'

Cement
200 Sacks

Formation:	Depth:
Surface Soil	30'
Sand	45
Shale, Shells & Sand	200
Shale & Shells	235
Lime & Pyrite Iron	280
Shale & Shells	390
Sand	430
Red Bed, Shale & Shells	740
Red Bed & Shale	785
Anhydrite	823
Shale & Shells	1229
Salt & Shale	1435
Shale & Shells	1475
Lime & Shale	1620
Sandy Lime, Shale & Pyrite	1655
Lime, Pyrite & Shale	1675
Broken Lime	1695
Lime & Shale	1800
Sandy Lime & Pyrite	1855
Sandy Lime & Shale	1935
Lime	2005
Lime & Shale	2210
Broken Lime	2245
Shale & Lime	2425
Shale & Shells	2590
Shale & Lime	2683
Lime	2700
Shale & Lime	2732
Lime	2962
Lime & Shale	2989
Lime	3108
Lime & Chert	3124
Lime & Shale	3164
Lime	3205
Lime & Shale	3230
Lime	3240

STATE OF KANSAS)
) SS
RUSSELL COUNTY)

FIL 5 15 14W
COA 37 18

I hereby certify that the above information is true and correct to the best of my knowledge.

Subscribed and sworn to before me this 24th day of December, 1945.

My Comm. Expires Oct 10 1946

Notary Public

STATE CORPORATION COMMISSION
DEC 26 1945