


STATE OF KANSAS  
STATE CORPORATION COMMISSION

Give All Information Completely  
Make Required Affidavit  
Mail or Deliver Report to:  
Conservation Division  
State Corporation Commission  
800 Bittling Building  
Wichita, Kansas

15.167.00226.00.00  
WELL PLUGGING RECORD

NORTH

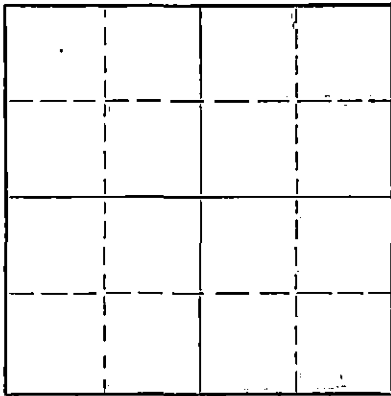

Locate well correctly on above  
Section Plat

Russell County. Sec. 4 Twp. 15 Rge. 14 (E) W (W)  
Location as "NE/CNW/SW" or footage from lines SE/4 NE/4 SW/4  
Lease Owner Louis M. Mai  
Lease Name Louis M. Mai H.R. Krug Well No. 1  
Office Address Russell, Kansas  
Character of Well (completed as Oil, Gas or Dry Hole)  
Date well completed 19  
Application for plugging filed 19  
Application for plugging approved 19  
Plugging commenced Sept 23 19 58  
Plugging completed Sept 27 19 58  
Reason for abandonment of well or producing formation

If a producing well is abandoned, date of last production 19  
Was permission obtained from the Conservation Division or its agents before plugging was commenced? yes.

Name of Conservation Agent who supervised plugging of this well  
Producing formation Depth to top Bottom Total Depth of Well 3265 Feet  
Show depth and thickness of all water, oil and gas formations.

OIL, GAS OR WATER RECORDS

CASING RECORD

FORMATION	CONTENT	FROM	TO	SIZE	PUT IN	PULLED OUT

Describe in detail the manner in which the well was plugged, indicating where the mud fluid was placed and the method or methods used in introducing it into the hole. If cement or other plugs were used, state the character of same and depth placed, from 3265 feet to surface feet for each plug set.

Hole filled with sand from 3265 to 3210 (Casing top perforations at 3220) Five sacks of cement placed in hole with dump bailer, pipe then shot off and pulled. Halliburton pump trucks pumped down fifteen sacks of drilling mud topped with seventy sacks of cement, plugging hole to bottom of cellar.  
Plugging Complete.

10-6-58  
RECEIVED  
STATE CORPORATION COMMISSION

OCT 6 1958

CC

(If additional description is necessary, use BACK of this sheet)

Name of Plugging Contractor Barnes and Sons Pipe Pulling Co  
Address Russell, Kansas.

STATE OF Kansas COUNTY OF Russell, ss.  
Louis M. Mai (employee of owner) or (owner or operator) of the above-described well, being first duly sworn on oath, says: That I have knowledge of the facts, statements, and matters herein contained and the log of the above-described well as filed and that the same are true and correct. So help me God.

(Signature) Louis M. Mai  
Russell, Kansas (Address)

SUBSCRIBED AND SWORN TO before me this 30 day of Sept 1958

April 23, 1962

My commission expires

Notary Public.

24-2675-S 2-52-20M

PLUGGING			
FILE	SEC 4	T. 15	R. 14W
BOOK	PAGE 120	LINE	23

PLUGGING  
FILE SEC 4 T 15 R 14w  
BOOK PAGE 128 LINE 23