


WELL PLUGGING RECORD

Give All Information Completely
Make Required Affidavit
Mail or Deliver Report to:
Conservation Division
State Corporation Commission
212 North Market, Insurance Bldg.
Wichita, Kansas

Russell County. Sec. 35 Twp 15S Rge. (E) 13 (W)

Location as "NE/CNW/SW" or footage from lines NW NE SE
Lease Owner Sunray DX Oil Company
Lease Name S. J. Sellens Well No. 11
Office Address P. O. Box 729, Great Bend, Kansas
Character of Well (completed as Oil, Gas or Dry Hole) Dry Hole
Date well completed October 3 19 65
Application for plugging filed October 6 19 65
Application for plugging approved October 5 19 65
Plugging commenced October 3 19 65
Plugging completed October 3 19 65
Reason for abandonment of well or producing formation
No commercial oil found.
If a producing well is abandoned, date of last production -- 19
Was permission obtained from the Conservation Division or its agents before plugging was commenced? Yes

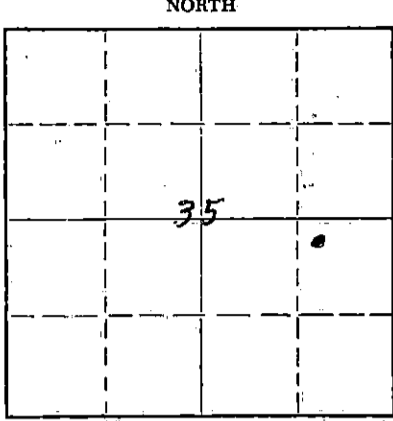

Locate well correctly on above Section Plat

Name of Conservation Agent who supervised plugging of this well Mr. Donald Truan, Russell, Kansas
Producing formation _____ Depth to top _____ Bottom _____ Total Depth of Well _____ Feet
Show depth and thickness of all water, oil and gas formations.

OIL, GAS OR WATER RECORDS

CASING RECORD

FORMATION	CONTENT	FROM	TO	SIZE	PUT IN	PULLED OUT
				8 5/8"	587	None

Describe in detail the manner in which the well was plugged, indicating where the mud fluid was placed and the method or methods used in introducing it into the hole. If cement or other plugs were used, state the character of same and depth placed, from _____ feet to _____ feet for each plug set.

Filled hole with Heavy Mud to 280 ft.,
Howco plug at 280 with 1/2 Sx. hulls;
25 Sx. cement plug, Howco plug with
1/4 Sx. Hulls 10 Sx. cement plug to
surface.

RECEIVED
STATE CORPORATION COMMISSION
NOV 2 1965
CONSERVATION DIVISION
Wichita, Kansas

(If additional description is necessary, use BACK of this sheet)
Name of Plugging Contractor Sterling Drilling Company
Address Sterling, Kansas

STATE OF Kansas, COUNTY OF Barton, ss.
F. S. Goddard (employee of owner) or (owner or operator) of the above-described well, being first duly sworn on oath, says: That I have knowledge of the facts, statements, and matters herein contained and the log of the above-described well as filed and that the same are true and correct. So help me God.

(Signature) *F. S. Goddard*
F. S. Goddard, District Production Manager
P. O. Box 729, Great Bend, Kansas
(Address)

SUBSCRIBED AND SWORN to before me this 28 day of October, 19 65

My commission expires February 22, 1967

D. L. Jackson
D. L. Jackson Notary Public.

STERLING DRILLING COMPANY
Sterling, Kansas

WELL LOG ----- Sellens #11
LOCATED: NW/4 NE/4 SE/4 Section 35-15S-13W, Russell County, Kansas.

OWNER: Sunray DK Oil Company
ROTARY DRILLING CONTRACTOR: Sterling Drilling Company

COMMENCED: September 25, 1965
COMPLETED: October 3, 1965

ROTARY TOTAL DEPTH: 3364'

LOG

0 - 105	Lime & Shale
105 - 450	Shale with Rock Ledges
450 - 594	Shale & Lime
594 - 1050	Red Bed, Shale & Lime
1050 - 1695	Shale & Lime
1695 - 2040	Lime
2040 - 2245	Shale
2245 - 2535	Shale & Sand
2535 - 2800	Shale & Lime
2800 - 3330	Lime
3330 - 3364	Shale & Lime T.D.

CASING RECORD

Ran 17 joints 8-5/8" seamless 24# surface casing. 579' pipe cemented at 587' K.B. with 400 sacks Pozmix, 3% HA-5. Plug was down at 1:30 a.m. by Howco on 9-26-65.

Filled hole to 40' with heavy mud. Plug with Howco plug, 1/4 sack hulls & 10 sacks cement to surface. Plugged at 8:30 a.m. Orders by State Plugger, Eldon Petty, Hays, Kansas.

RECEIVED
STATE CORPORATION COMMISSION
NOV 2 1965
CONSERVATION DIVISION
Wichita, Kansas