


STATE OF KANSAS
STATE CORPORATION COMMISSION

Give All Information Completely
Make Required Affidavit
Mail or Deliver Report to:
Conservation Division
State Corporation Commission
800 Bittling Building
Wichita, Kansas

15.167.04256.00.00

WELL PLUGGING RECORD

NORTH

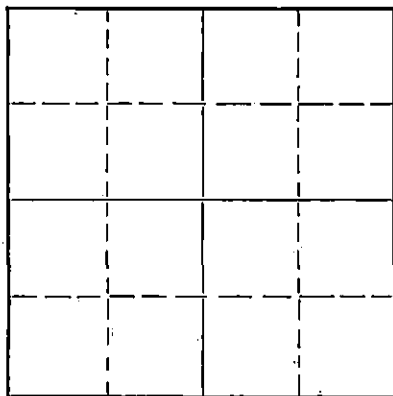

Locate well correctly on above
Section Flat

Russell County, Sec. 35 Twp. 15S. Rge. #13 (W)
Location as "NE/CNW 1/4 SW 1/4" or footage from lines C-NE NW NW
Lease Owner Sunray Oil Corporation
Lease Name Tom Sellens Well No. 2
Office Address Box 195, Great Bend, Kansas
Character of Well (completed as Oil, Gas or Dry Hole) Dry Hole
Date well completed 3-28. 19. 52
Application for plugging filed 3-31. 19. 52
Application for plugging approved 3-31. 19. 52
Plugging commenced 3-28. 19. 52
Plugging completed 3-28. 19. 52
Reason for abandonment of well or producing formation Dry Hole
If a producing well is abandoned, date of last production 19.
Was permission obtained from the Conservation Division or its agents before plugging was commenced? Yes

Name of Conservation Agent who supervised plugging of this well C. D. Stough
Producing formation Depth to top Bottom Total Depth of Well 3329 Feet
Show depth and thickness of all water, oil and gas formations.

OIL, GAS OR WATER RECORDS

CASING RECORD

Formation	Content	From	To	Size	Put In	Pulled Out
Lansing	Dry	3031	3208	8-5/8"	529'	None
Arbuckle	Dry	3304	3329			

Describe in detail the manner in which the well was plugged, indicating where the mud fluid was placed and the method or methods used in introducing it into the hole. If cement or other plugs were used, state the character of same and depth placed, from feet to feet for each plug set.

Mudded hole to 300'. Set plug at 300' w/20 sax cement on plug. Mudded hole to 35'. Set plug at 35' w/15 sax cement on top to complete plugging.

STATE
APR 14 1952
CC

Plugging Contractor: Stickle Drilling Co., Philtower Bldg., Tulsa, Oklahoma

(If additional description is necessary, use BACK of this sheet)

Correspondence regarding this well should be addressed to Sunray Oil Corporation
Address Box 195, Great Bend, Kansas

STATE OF KANSAS, COUNTY OF BARTON, ss.
W. E. Westbrook, Jr. (employee of owner) of the above-described well,
being first duly sworn on oath, says: That I have knowledge of the facts, statements, and matters herein contained and the log of the above-described well as filed and that the same are true and correct. So help me God.

(Signature) W. E. Westbrook, Jr. Jr. Engr.
Box 195, Great Bend, Kansas
(Address)

SUBSCRIBED AND SWORN to before me this 2nd day of April, 19. 52

Martha Scott
Notary Public.

My commission expires April 19, 1952

PLUGGING
FILE SEC 3 ST 15 R 13 W
BOOK PAGE 5 LINE 15

Sunray Oil Corporation
Tulsa, Oklahoma

Tulsa, Oklahoma
April 1, 1952

Stickle Drilling Company - Contractor
Drilling Commenced: March 14, 1952
Drilling Completed: March 28

Tom Sellens #2
C-NE $\frac{1}{4}$ -NW $\frac{1}{4}$ -NW $\frac{1}{4}$ -
Sec. 35-15S-13W
Russell Co., Kansas

DRILLERS LOG

Surface Clay & Postrock	0-40
Shale & Shells	40-165
Sand & Shale	165-190
Shale	190-220
Shale & Shells	220-500
Red Bed	500-790
Anhydrite	790-825
Shells & Shale	825-1140
Shale & Shells	1140-1460
Shale & Lime	1460-1700
Lime & Shale	1700-1810
Lime	1810-2085
Lime & Shale	2085-2200
Shale & Lime	2200-2345
Shale & Shells	2345-2500
Shale & Lime	2500-2565
Lime & Shale	2565-2580
Shale & Shells	2580-2670
Shale & Lime	2670-2740
Lime	2740-3274
Conglomerate	3274-3305
Arbuckle	3305-3329 TD

I, Frank E. Stickle, hereby certify, the above to be a true and complete drillers log of Sunray Oil Corporation's Tom Sellens #2, Center of NE $\frac{1}{4}$ -NW $\frac{1}{4}$ -NW $\frac{1}{4}$ -Section 35-15S-13W-Russell County, Kansas.

Frank E. Stickle
Frank E. Stickle

Lillian T. Bonham
Notary Public

February 13, 1956
My commission expires

PLUGGING
FILE SEC 35-15S-13W
BOOK PAGE 6 LINE 15