


15. 167. 04208. 00. 00

WELL PLUGGING RECORD

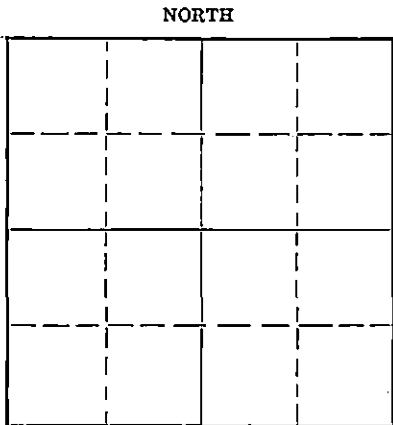

Locate well correctly on above Section Plat

Russell County. Sec. 20 Twp. 15S. Rge. (E) 13 (W)
 Location as "NE/CNW $\frac{1}{4}$ SW $\frac{1}{4}$ " or footage from lines CENTER W/2 W/2 SW/4
 Lease Owner Jones-Shelburne, Inc.
 Lease Name Sollens "C"
 Office Address Russell, Kansas
 Character of Well (completed as Oil, Gas or Dry Hole) Dry Hole
 Date well completed September 5 1950
 Application for plugging filed September 11 1950
 Application for plugging approved September 11 1950
 Plugging commenced September 12 1950
 Plugging completed September 13 1950
 Reason for abandonment of well or producing formation Non-productive

If a producing well is abandoned, date of last production Dry Hole 19
 Was permission obtained from the Conservation Division or its agents before plugging was commenced? Yes

Name of Conservation Agent who supervised plugging of this well Mr. Elden Petty
 Producing formation Depth to top Bottom Total Depth of Well 3286 Feet
 Show depth and thickness of all water, oil and gas formations.

OIL, GAS OR WATER RECORDS

CASING RECORD

Formation	Content	From	To	Size	Put In	Pulled Out
				5 1/2"	3,256	2,900'

Describe in detail the manner in which the well was plugged, indicating where the mud fluid was placed and the method or methods used in introducing it into the hole. If cement or other plugs were used, state the character of same and depth placed, from feet to feet for each plug set.

- Hole filled with mud and plugged back to 2,950 feet and circulated with mud.
- Pipe was ripped at 2,900 feet and recovered same.
- Hole bridged at 250 feet with 40 sacks of cement, filling to 180 feet.
- Twenty sacks of cement in bottom of cellar or from 15 feet up.

RECEIVED
 Conservation Div.
 SEP 21 1950
 STATE CORPORATION
 COMMISSION
 KANSAS

9-21-50

(If additional description is necessary, use BACK of this sheet)

Correspondence regarding this well should be addressed to Jones-Shelburne, Inc.
 Address Russell, Kansas

STATE OF Kansas, COUNTY OF Russell, ss.
 Samuel J. Beamer (employee of owner) or (owner or operator) of the above-described well,
 being first duly sworn on oath, says: That I have knowledge of the facts, statements, and matters herein contained and the log of the above-described well as filed and that the same are true and correct. So help me God.

(Signature) Samuel J. Beamer
 Russell, Kansas
 (Address)

SUBSCRIBED AND SWORN to before me this 15th day of September, 1950

Phyllis Bethany
 Notary Public.

My commission expires June 3, 1953

22-7877-8 4-49-10M

PLUGGING
 FILE SEC-20 T-15 R-13 W
 BOOK PAGE 28 LINE 14

Julian Oil & Royalty Co.

Oklahoma City, Okla.

CONTRACTOR'S VERIFIED LOG

Operator Jones-Shelburne, Inc. Farm Name Sellens #C# Well No. 2
 Location Center of W/2 of W/2 of SW/4
 Pool Name Trapp County Russell State Kansas
 Commencement Date June 29, 1950 Completion Date September 8, 1950

Log of Well

Depth		Formation	Deviation from vertical (degrees)	Remarks
From	To			
0	115	Shale		
115	180	Red Rock		
180	190	Shale		
190	195	Red Rock		
195	200	Shale		
200	220	Red Rock		
220	270	Shale		
270	278	Sand		
278	290	Shale		
290	320	Sand		
320	425	Shale		
425	758	Red Rock		
758	763	Chalk		
763	795	Lime		
795	975	Red Rock		
975	1015	Shale		
1015	1070	Red Rock		
1070	1175	Shale		
1175	1425	Salt		
1425	1430	Shale		
1430	1475	Lime		
1475	1485	Shale		
1485	1510	Lime		
1510	1520	Shale		
1520	1530	Lime		
1530	1540	Shale		
1540	1555	Lime		
1555	1565	Shale		
1565	1580	Lime		
1580	1585	Shale		
1585	1600	Red Rock		
1600	1630	Lime		
1630	1650	Shale & shells		
1650	1695	Lime		
1695	1700	Shale		
1700	1710	Red Rock		
1710	1785	Lime		
1785	1830	Lime & shale breaks		
1830	1850	Lime		
1850	1860	Shale		
1860	1905	Lime		
1905	1935	Shale & lime		
1935	1940	Red rock		
1940	1965	Lime, shells & shale		
1965	1980	Lime		
1980	1990	Red Rock		
1990	2060	Lime		
2060	2062	Red Rock		
2062	2080	Lime		
2080	2087	Shale		
2087	2093	Lime		
2093	2100	Shale		
2100	2105	Lime		

RECEIVED
 Conservation Div.
 SEP 21 1950
 STATE CORPORATION
 COMMISSION
 KANSAS

PLUGGING
 FILE SEC-20-15-213W
 PAGE 28

(Well Log Continued)

Depth		Formation	Deviation from vertical (degrees)	Remarks	
From	To				
2105	2130	Shale shells	2555	2560	Shale
2130	2135	Lime	2560	2570	Lime
2135	2145	Red rock	2570	2575	Shale
2145	2160	Lime	2575	2580	Lime
2160	2166	Shale	2580	2620	Shale
2166	2190	Lime	2620	2655	Lime
2190	2210	Shale	2655	2660	Shale
2210	2220	Lime	2660	2670	Lime
2220	2225	Shale	2670	2680	Shale
2225	2230	Lime	2680	2785	Lime
2230	2235	Shale	2785	2790	Shale
2235	2275	Lime, shells & shale	2790	2915	Lime
2275	2285	Lime shells	2915	2920	Shale
2285	2287	Lime	2920	2925	Lime
2287	2310	Shale	2925	2932	Shale
2310	2315	Lime	2932	2950	Lime
2315	2335	Shale	2950	2955	Red rock
2335	2342	Red rock	2955	2983	Shale
2342	2352	Lime	2983	3186	Lime
2352	2355	Shale	3186	3212	Shale
2355	2360	Lime	3212	3248	Lime
2360	2365	Red rock	3248	3252	Shale
2365	2370	Tarkio	3252	3285	Lime
2370	2375	Lime	3285	3285	Total Depth
2375	2378	Shale			
2378	2381	Lime			
2381	2416	Sandy shale			
2416	2440	Lime			
2440	2460	Sandy shale			
2460	2470	Lime			
2470	2477	Shale			
2477	2490	Lime			
2490	2505	Shale			
2505	2525	Shale			
2525	2530	Lime			
2530	2540	Shale			
2540	2545	Red rock			
2545	2548	Lime			
2548	2550	Shale			
2550	2555	Lime			

Total Depth 3285

Was well to be deepened by another Contractor? No

CASING LEFT IN HOLE AFTER COMPLETION OR ABANDONMENT

Size	Wt.	Grade	Range	Thread	FOOTAGE					
					Delivered	Run	Set At	Pulled	Unused	Left in Hole
5 1/2"			Cemented with 75 sacks cement				3,256	2,900		356

Deviation From Vertical Data Is Correct as Shown

Company Superintendent

(This space for Company use)

The foregoing Well Log and other data are correct.

JULIAN OIL & ROYALTY CO.

Contractor

By *Sam Deamer*