


WELL PLUGGING RECORD

Give All Information Completely  
Make Required Affidavit  
Mail or Deliver Report to:  
Conservation Division  
State Corporation Commission  
800 Bitting Building  
Wichita, Kansas

NORTH

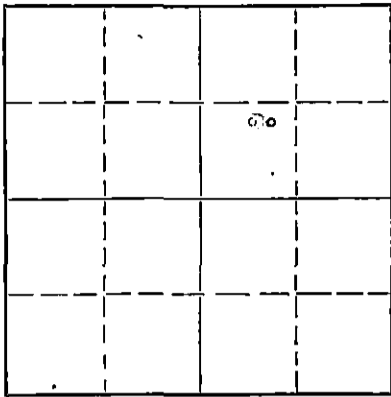

Locate well correctly on above  
Section Plat

Russell County. Sec. 14 Twp. 15 Rge. 13 (X) W (W)  
Location as "NE/CNW/SW" or footage from lines NE SW NE  
Lease Owner Duke Drilling Co.  
Lease Name KEJR B Well No. 1  
Office Address Box 823 - Great Bend, Ks.  
Character of Well (completed as Oil, Gas or Dry Hole) Dry Hole  
Date well completed 10-23 19 66  
Application for plugging filed 10-23 19 66  
Application for plugging approved 10-23 19 66  
Plugging commenced 10-23 19 66  
Plugging completed 10-23 19 66  
Reason for abandonment of well or producing formation \_\_\_\_\_

If a producing well is abandoned, date of last production \_\_\_\_\_ 19 \_\_\_\_  
Was permission obtained from the Conservation Division or its agents before plugging was commenced? yes

Name of Conservation Agent who supervised plugging of this well Mr. Don Truan  
Producing formation \_\_\_\_\_ : Depth to top \_\_\_\_\_ Bottom \_\_\_\_\_ Total Depth of Well 3285 Feet  
Show depth and thickness of all water, oil and gas formations.

OIL, GAS OR WATER RECORDS

CASING RECORD

FORMATION	CONTENT	FROM	TO	SIZE	PUT IN	PULLED OUT

Describe in detail the manner in which the well was plugged, indicating where the mud fluid was placed and the method or methods used in introducing it into the hole. If cement or other plugs were used, state the character of same and depth placed, from \_\_\_\_\_ feet to \_\_\_\_\_ feet for each plug set.

Filled hole with heavy mud to 260'  
Set plug 1/4 sack hulls, cemented with 25 sacks cement thru drill pipe  
Filled hole to 40' - set plug 1/2 sack hulls,  
cemented with 10 sacks cement.

Plugged rat hole - 2 sacks cement.

RECEIVED  
STATE CORPORATION COMMISSION

OCT 26 1966

CONSERVATION DIVISION  
WICHITA, KANSAS

10-27-66

(If additional description is necessary, use BACK of this sheet)

Name of Plugging Contractor \_\_\_\_\_  
Address \_\_\_\_\_

STATE OF ~~KANSAS~~ KANSAS, COUNTY OF BARTON, ss.  
L. O. CHUBB (employee of owner) or ~~owner~~ owner of the above-described well, being first duly sworn on oath, says: That I have knowledge of the facts, statements, and matters herein contained and the log of the above-described well as filed and that the same are true and correct. So help me God.

(Signature) L. O. Chubb

Box 823 - Great Bend, Kansas  
(Address)

SUBSCRIBED AND SWORN TO before me this 25th day of October, 1966.

My commission expires April 11, 1970

Dorothy M. Hague  
Dorothy M. Hague  
Notary Public.

W E L L L O G

DATE COMMENCED: October 15, 1966  
DATE COMPLETED: October 23, 1966

Duke Drilling Company  
KEJR B-1  
NE-SW NE Sec. 14-15-13w  
Russell Co., Kansas

0	-	60'	Clay & Post Rock
60	-	450'	Shale Clay & Sand
450	-	750'	Red Shale & Sand
750	-	790'	ANHYDRITE
790	-	1030'	Red Bed
1030	-	1450'	Shale
1450	-	1950'	Lime & Shale
1950	-	2550'	Shale & Lime
2550	-	2885'	Lime
2885	-	2889'	Shale
2889	-	2929'	Lime & Shale
2929	-	2975'	Shale
2975	-	2989'	Lime & Shale
2989	-	3250'	Lime
3250	-	3285'	Conglomerate

ELEVATION: 1794 K.B.

FORMATION DATA

ANHYDRITE	750
HEEBNER	2885
DOUGLAS	2929
BROWN LIME	2975
LANSING	2989
CONGLOMERATE	3250
RTD	3285

RECEIVED  
STATE CORPORATION COMMISSION

OCT 27 1966

CONSERVATION DIVISION  
Wichita, Kansas

A F F I D A V I T

SURFACE CASING: Set 8-5/8" at 276' with 175 sacks cement.

STATE OF KANSAS  
COUNTY OF BARTON ss.

L. O. Chubb, of lawful age, does swear that the facts and statements herein contained are true and correct to the best of his knowledge.

L. O. Chubb  
L. O. Chubb

Subscribed and sworn to before me this 25 day of October, 1966.

My Commission Expires:

4-11-70

Dorothy M. Hague  
Dorothy M. Hague NOTARY PUBLIC