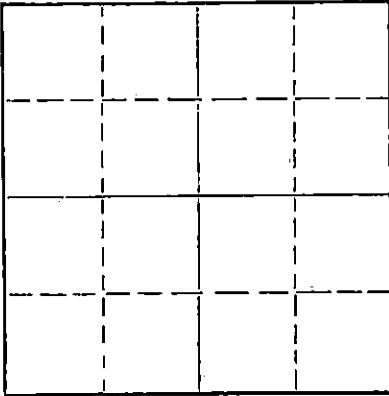


Give All Information Completely
Make Required Affidavit
Mail or Deliver Report to:
Conservation Division
State Corporation Commission
211 No. Broadway
Wichita, Kansas

WELL PLUGGING RECORD

15. 167. 00585. 00. 00

NORTH

Locate well correctly on above
Section Plat

Russell County. Sec. 30 Twp. 15 Rge. (X) 14 (W)
Location as "NE/CNW/SW" or footage from lines C-SW SE NE
Lease Owner Olympic Petroleum Co.
Lease Name LaVerne Becker Well No. 1
Office Address 204 Columbia Bldg., Tulsa 14, Okla.
Character of Well (completed as Oil, Gas or Dry Hole) Hole Dry
Date well completed October 25, 1962 19 62
Application for plugging filed October 25, 1962 19 62
Application for plugging approved _____ 19 _____
Plugging commenced October 25, 19 62
Plugging completed 5:30 A. M. October 25, 19 62
Reason for abandonment of well or producing formation Hole Dry

If a producing well is abandoned, date of last production _____ 19 _____
Was permission obtained from the Conservation Division or its agents before plugging was commenced? Yes

Name of Conservation Agent who supervised plugging of this well Donald Truan, State Plugger, Russell, Kansas.
Producing formation _____ Depth to top _____ Bottom _____ Total Depth of Well _____ Feet
Show depth and thickness of all water, oil and gas formations.

OIL, GAS OR WATER RECORDS

CASING RECORD

FORMATION	CONTENT	FROM	TO	SIZE	PUT IN	PULLED OUT
Clay		0	90			
Shale and Shells		90	339	8 5/8"	341 ft.	None

Describe in detail the manner in which the well was plugged, indicating where the mud fluid was placed and the method or methods used in introducing it into the hole. If cement or other plugs were used, state the character of same and depth placed, from _____ feet to _____ feet for each plug set.

Built bridge at 330 ft. with Cottonseed hulls and rock.
Poured 25 sacks cement through drill pipe to 330 ft.
Filled with mud to 40 ft. of top. Cemented with $\frac{1}{2}$ sack
hulls and 10 sacks cement, two sacks in rathole.

11-1-62

RECEIVED
STATE CORPORATION COMMISSION

OCT 1 1962

CONSERVATION DIVISION
Wichita, Kansas

(If additional description is necessary, use BACK of this sheet)

Name of Plugging Contractor Blackstone Drilling, Inc.
Address Box # 455, McPherson, Kansas

STATE OF Oklahoma, COUNTY OF Tulsa, ss.

James Silver of Olympic Petroleum Co. (operator) of the above-described well, being first duly sworn on oath, says: That I have knowledge of the facts, statements, and matters herein contained and the log of the above-described well as filed and that the same are true and correct. So help me God.


(Signature)

James E. Silver

204 Columbia Bldg., Tulsa 14, Okla.

SUBSCRIBED AND SWORN to before me this 31 day of October, 19 62My commission expires May 27, 1964

Notary Public.

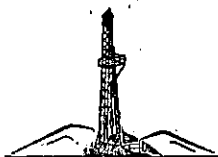

Blackstone Drilling, Inc.

Box 455 • 523 West Kansas • Phone CH 1-1250

McPHERSON • KANSAS

October 26, 1962

COMPANY: OLYMPIC PETROLEUM CO.
CONTRACTOR: BLACKSTONE DRILLING, INC.
FARM: LA VERNE BECKER # 1
LOCATION: C-SW SE NE, Sec. 30-15-14W,
Russell County, Kansas
COMMENCED: October 16, 1962
COMPLETED: October 25, 1962
ELEVATION: 1833 K.B.

0	to	90	Clay
90	to	878	Shale and Shells
878	to	914	Anhydrite
914	to	1600	Shale and Shells
1600	to	1670	Shale and Lime
1670	to	1975	Lime
1975	to	2777	Lime and Shale
2777	to	2800	Shale
2800	to	2860	Topeka Lime
2860	to	3358	Lime
3358	to	3378	Arbuckle
		3378	T. D.

RECEIVED
STATE CORPORATION COMMISSION

NOV 1 1962

CONSERVATION DIVISION
Wichita, Kansas

Cut 12 $\frac{1}{4}$ in. hole to 339 ft. and run 341 ft. of 8 5/8 in. surface pipe. Cemented on bottom at 339 ft. with 175 sacks cement and 5 sacks chloride. Cut 7 7/8 in. hole to 3378 ft. T.D. Hole dry and abandoned. Built bridge at 330 ft. with Cottonseed hulls and rock. Poured 25 sacks cement through drill pipe to 330 ft. Filled with mud to 40 ft. of top. Cemented with $\frac{1}{2}$ sack hulls and 10 sacks cement, two sacks in rathole. Hole plugging completed at 5:30 A. M. October 25, 1962, by Donald Truan, State Plugger, Russell, Kansas.

TOPS: KANSAS CITY - 3093' ARBUCKLE - 3358'

Measurements taken from K. B.

I, H. J. Plouffe, President of Blackstone Drilling, Inc., do hereby certify that the above and foregoing is a true and correct copy of log on the LaVerne Becker #1, located on Sec. 30-15-14W, Russell County, Kansas as reflected by files of the Blackstone Drilling, Inc.

H. J. Plouffe
H. J. Plouffe, President

Subscribed and sworn to before me a Notary Public, within and for McPherson County, Kansas this 29th day of October, 1962.

Ruth McVay
Ruth McVay - Notary Public

My Commission Expires: 12/18/65