

B. 167.30217.00.00

STATE OF KANSAS
STATE CORPORATION COMMISSION

Form CP-4

WELL PLUGGING RECORD

Give All Information Completely
Make Required Affidavit
Mail or Deliver Report to:
Conservation Division
State Corporation Commission
211 No. Broadway
Wichita, Kansas

Russell County. Sec. 31 Twp. 15S Rgc. 14 (25) (W)

Location as "NE/CNW/SW" or footage from lines NW NW SW

Lease Owner Helmerich & Payne, Inc.

Lease Name Elsasser "A" Well No. 1

Office Address Utica at Twenty-First, Tulsa, Oklahoma

Character of Well (completed as Oil, Gas or Dry Hole) Dry Hole

Date well completed 4-26 1966

Application for plugging filed 4-26 1966

Application for plugging approved 4-26 1966


Plugging commenced 4-26 1966

Plugging completed 4-26 1966

Reason for abandonment of well or producing formation Dry Hole

If a producing well is abandoned, date of last production 19

Was permission obtained from the Conservation Division or its agents before plugging was commenced? Yes

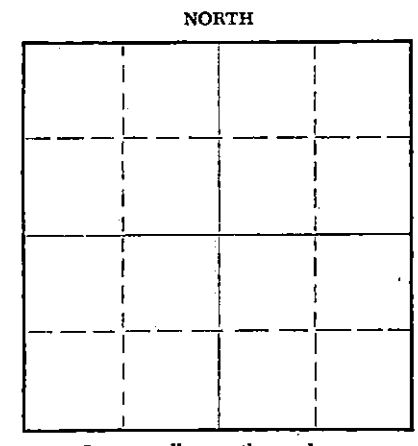

Name of Conservation Agent who supervised plugging of this well Don Truman

Producing formation _____ Depth to top _____ Bottom _____ Total Depth of Well _____ Feet

Show depth and thickness of all water, oil and gas formations.

OIL, GAS OR WATER RECORDS

CASING RECORD

FORMATION	CONTENT	FROM	TO	SIZE	PUT IN	PULLED OUT

Describe in detail the manner in which the well was plugged, indicating where the mud fluid was placed and the method or methods used in introducing it into the hole. If cement or other plugs were used, state the character of same and depth placed, from _____ feet to _____ feet for each plug set.

3433' - 260' Heavy rotary mud
260' HB plug, 25 sacks cement, 1/2 sack hulls
260' - 40' Heavy rotary mud
40' - GL HB Plug, 1/2 sack hulls, 15 sacks cement

RECEIVED
STATE CORPORATION COMMISSION
MAY 2 - 1966
CONSERVATION DIVISION
WICHITA, KANSAS

(If additional description is necessary, use BACK of this sheet)
Name of Plugging Contractor Peel Brothers, Inc.
Address Box 359, Hoisington, Kansas

STATE OF Kansas, COUNTY OF Barton, ss.
Peel Brothers, Inc. (employee of owner) W. E. "Jack" Mattocks of the above-described well, being first duly sworn on oath, says: That I have knowledge of the facts, statements, and matters herein contained and the log of the above-described well as filed and that the same are true and correct. So help me God. PEEL BROTHERS, INC.

(Signature) Jack Mattocks
W. E. "Jack" Mattocks
Drilling Superintendent

SUBSCRIBED AND SWORN TO before me this 28th day of April, 19 66

My commission expires 6-21-66
Ethel S. Williamson
Notary Public.

DRILLER'S LOG

Well Owner: Helmerich & Payne, Inc.
Farm Name: Elsasser "A" #1
Date Started: 4-16-66
Date Completed: 4-26-66
Total Depth: 3433'

NW NW SW
Section 31-15S-14W
Russell County, Kansas

Casing: 8-5/8" set at 257' cemented

Contractor: Peel Brothers, Inc.

Figures below are bottoms of formations:

Surface Clay and Post Rock	0 - 75
Shells and Shale	260
Sand	330
Shale	670
Shale and Shells	939
Anhydrite	967
Red Bed and Shale	1335
Shale and Lime	2885
Lime and Shale	3000
Lime	3433
Total Depth	3433

RECEIVED
STATE CORPORATION COMMISSION

MAY 2 - 1966

REGISTRATION DIVISION
Topeka, Kansas

This is to certify that the above information is to the best of our knowledge true and correct.

PEEL BROTHERS, INC.

Jack W. Mattocks
W. E. "Jack" Mattocks
Drilling Superintendent

SUBSCRIBED AND SWORN to before me this 28th day of April, 1966.

Ethel S. Williamson
Ethel S. Williamson
Notary Public

My commission expires 6-21-66