


STATE OF KANSAS
STATE CORPORATION COMMISSION

Give All Information Completely
Make Required Affidavit
Mail or Deliver Report to:
Conservation Division
State Corporation Commission
800 Bittling Building
Wichita, Kansas

WELL PLUGGING RECORD

NORTH

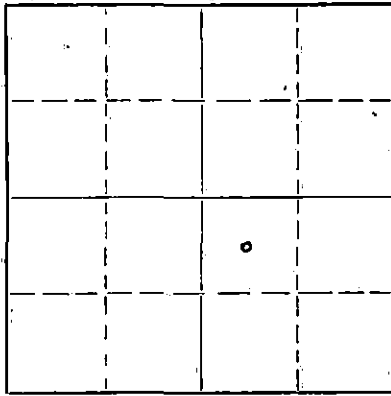

Locate well correctly on above
Section Plat

Reno County. Sec. 33 Twp. 24 Rge. (E) 5 (W)

Location as "NE/CNW%SW%" or footage from lines Cntr NW SE

Lease Owner Drillers Production Co., Inc.

Lease Name Haines Well No. 1

Office Address Insurance Bldg. 212 N. Market Street, Wichita, Kansas

Character of Well (completed as Oil, Gas or Dry Hole) Gas

Date well completed January 5 1938

Application for plugging filed March 8 1952

Application for plugging approved March 10 1952

Plugging commenced June 7 1952

Plugging completed June 12 1952

Reason for abandonment of well or producing formation Depleted

If a producing well is abandoned, date of last production March 11 1952

Was permission obtained from the Conservation Division or its agents before plugging was commenced? yes

Name of Conservation Agent who supervised plugging of this well Ruhl Durkee

Producing formation Mississippian Depth to top 3408 Bottom - Total Depth of Well 3549 Feet

Show depth and thickness of all water, oil and gas formations. PB 3463

OIL, GAS OR WATER RECORDS

CASING RECORD

FORMATION	CONTENT	FROM	TO	SIZE	PUT IN	PULLED OUT
Mississippi	Gas & Oil	3422	3487	12" - 1/2"	116'	none
				10" - 3/4"	473'	175.64'
				7"	3472'	1580.05'

Describe in detail the manner in which the well was plugged, indicating where the mud fluid was placed and the method or methods used in introducing it into the hole. If cement or other plugs were used, state the character of same and depth placed, from _____ feet to _____ feet for each plug set.

Filled hole with coarse sand 3463 - 3405. Ran 6 sacks cement.
Pulled 419.34' of 7" casing. Recemented 7" casing @ 1720 1/2' w/
50 sacks cement to test shallow zones. Pulled 1160.71' 7" casing,
pulled 175.64' 10 3/4" casing. Mudded hole to 250'. Rock bridge &
10 sacks cement. Mud to 175', bridge & 15 sacks cement. Mud to 10'
& 10 sacks cement.

RECEIVED
STATE CORPORATION COMMISSION
JUL 12 1952
CONSERVATION DIVISION
Wichita, Kansas

7-12-52

(If additional description is necessary, use BACK of this sheet)
Name of Plugging Contractor Drillers Production Co., Inc.
Address Insurance Bldg., 212 North Market St. Wichita 2, Kansas

STATE OF Kansas, COUNTY OF Sedgwick, ss.
G. R. Bickford, Jr. (employee of owner) or (owner) of the above-described well, being first duly sworn on oath, says: That I have knowledge of the facts, statements, and matters herein contained and the log of the above-described well as filed and that the same are true and correct. So help me God.

(Signature) G. R. Bickford, Jr.
Insurance Bldg., 212 North Market St. Wichita, Ks.
(Address)

SUBSCRIBED AND SWORN TO before me this July 10 day of July 10, 19 52
Bertha L. Wilson
Notary Public.

My commission expires Aug. 13, 1955


PLUGGING
FILE SEC 33 T 24 R SW
BOOK PAGE 149 LINE 2

SALT CITY GAS CO.
 Haynes No. 1.

SEC. 33 T. 24 R. 5W.
 CNW SE

Total Depth. 3549 P.B. 3463
 Comm. 11-21-37 Comp. 1-5-38
 Shot or Treated.
 Contractor. Springrose Drlg. Co.
 Issued. 3-19-38

County Reno.

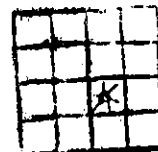

CASING.

12 1/2" 116'
 10 3/4" 473'
 7" 3412'

Elevation. 1555'

Production. 1,500,000 G.

Figures Indicate Bottom of Formations.

surface	55
sand	70
sand shell and shale	116
shale and sand	155
shale and shells	300
lime and shale	410
reamed 116-	410
lime and shale	460
broken lime	490
shale and lime	1080
salt shale and shells	1110
lime and shale	1190
gyp lime and shale	1235
lime and shale	1360
broken lime	1540
shale lime shells	1900
shale and lime	2195
lime	2360
sdv lime	2395
lime	2550
sand lime and shale	2615
broken lime	2685
lime	2925
broken lime	2985
lime	3010
broken lime	3038
lime	3095
broken lime	3125
lime	3150
lime and shale	3408 1/2
chat	3465
sand and lime	3480
chert white	3486
lime	3500
sand	3507
water sand	3515
lime white hard	3525
lime hard	3530
lime soft wh water	3549
Total Depth.	

Plugged back to 3463

RECORDED
 INDEXED
 MAR 21 1938

PLUGGING
 FOR SEC. 33 T. 24 R. 5W
 FOR PAGE 179 LINE 2