


STATE OF KANSAS
STATE CORPORATION COMMISSION

Give All Information Completely
Make Required Affidavit
Mail or Deliver Report to:
Conservation Division
State Corporation Commission
211 No. Broadway
Wichita, Kansas

WELL PLUGGING RECORD

NORTH

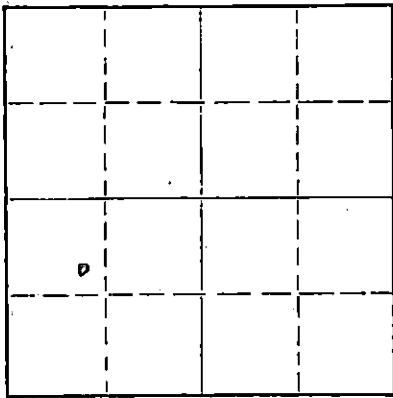

Locate well correctly on above
Section Plat

Reno County, Sec. 34 Twp. 24S Rge. 5 (X) (W)
Location as "NE/CNW/SW" or footage from lines SE NW SW
Lease Owner Brunson-Spines
Lease Name Haines Well No. 1
Office Address 333 First Nat'l. Bank Bldg., Wichita, Kansas
Character of Well (completed as Oil, Gas or Dry Hole) Dry hole.
Date well completed 7-29- 19 58
Application for plugging filed 7-29- 19 58
Application for plugging approved 19
Plugging commenced 7-29- 19 58
Plugging completed 7-29- 19 58
Reason for abandonment of well or producing formation Dry hole.

If a producing well is abandoned, date of last production 19
Was permission obtained from the Conservation Division or its agents before plugging was commenced? Yes

Name of Conservation Agent who supervised plugging of this well Gilbert Toman
Producing formation Depth to top Bottom Total Depth of Well 1610 Feet
Show depth and thickness of all water, oil and gas formations.

OIL, GAS OR WATER RECORDS

CASING RECORD

FORMATION	CONTENT	FROM	TO	SIZE	PUT IN	PULLED OUT
				8-5/8"	453'	None

Describe in detail the manner in which the well was plugged, indicating where the mud fluid was placed and the method or methods used in introducing it into the hole. If cement or other plugs were used, state the character of same and depth placed, from feet to feet for each plug set.

Hole circulated with heavy mud. Pushed plug to 440', covered with 1/2 sack
hulls and 20 sacks cement, mixed and poured through 14 joints of Drill Pipe.
Hole filled to 35' of cellar. Pushed plug to 35', covered with 1/2 sack
hulls and 10 sacks cement. Job completed at 7:30 a.m.

(If additional description is necessary, use BACK of this sheet)

Name of Plugging Contractor Brunson Production & Exploration, Inc.,
Address 333 First Nat'l. Bank Bldg., Wichita, Kansas

STATE OF KANSAS, COUNTY OF SEDGWICK, ss.


Ralph B. McLaughlin (employee of owner) of the above-described well, being duly sworn on oath, says: That I have knowledge of the facts, statements, and matters herein contained and the log of the well as filed and that the same are true and correct. So help me God.

(Signature) Ralph B. McLaughlin
333 First Nat'l. Bank Bldg., Wichita, Ks.
(Address)

SWORN TO before me this 27th day of August, 19 58

Mary G. LaFollette
Mary G. LaFollette, Notary Public.

June 16, 1959

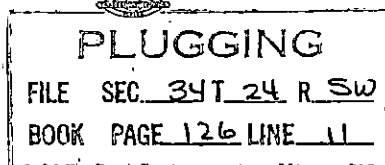

RECEIVED
STATE CORPORATION COMMISSION
8-28-58
AUG 28 1958
CONSERVATION DIVISION
Wichita, Kansas

BRUNSON-SPINES
Wichita, Kansas

WELL: HAINES #1

SE NW SW

COMMENCED RD: 7-22-58

34-24S-5W

COMPLETED RD: 7-29-58

RENO COUNTY, KANSAS

TOTAL DEPTH: 1610'

ELEVATION: 1532 DF


CASING: 453' 8-5/8"

CONTRACTOR: BRUNSON PROD. & EXPLOR. INC.

STRATA	DEPTH	TOPS
Clay & Sand	55	Florence Chert 1026 (#506)
Chat	65	Wreford 1048 (#484)
Red Rock	116	Cottonwood 1304 (#228)
Red Bed	125	Neva 1356 (#176)
Shale & Clay	217	Fouracre 1484 (# 48)
Shale & Clay with Lime Streaks	414	Indian Caves Sand 1584 (- 52)
Anhydrite	453	Basal Sand 1606 (- 74)
Shale & Shells	525	
Shale & Salt	605	
Shale & Shells	670	
Shale & Lime	965	
Sandy Lime	1062	
Lime & Chert	1190	
Lime & Shale	1530	
Lime	1568	
Lime & Shale	1610	
Total Depth	1610	
	D&A	


I hereby certify that the above is a true and correct log of said well as reflected by the daily drilling report.

BRUNSON-SPINES

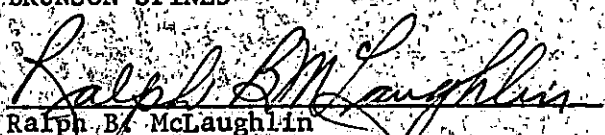
Ralph B. McLaughlin

Signed and sworn to in my presence this 26th day of August, 1958, by Ralph B. McLaughlin, of Brunson-Spines.

RECEIVED
REGISTRATION COMMISSION

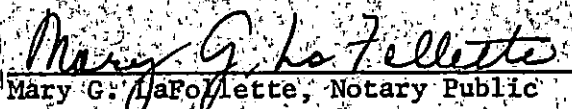
Mary G. LaFollette, Notary Public

My commission expires June 16, 1959. AUG 27 1958

CONSERVATION DIVISION
Wichita, Kansas

PLUGGING
FILE SEC 34 T 24 R SW
BOOK PAGE 126 LINE 11