


Give All Information Completely
Make Required Affidavit
Mail or Deliver Report to:
Conservation Division
State Corporation Commission
211 No. Broadway
Wichita, Kansas

WELL PLUGGING RECORD

NORTH

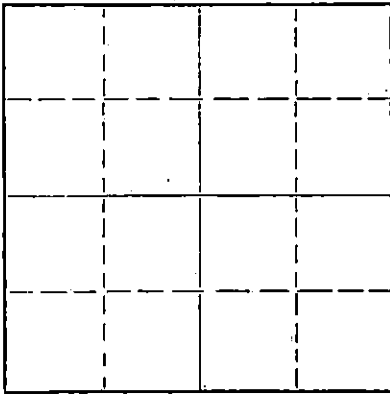

Locate well correctly on above
Section Plat

Reno County, Sec. 17 Twp. 24S Rge. 7W (E) (W)
Location as "NE/CNW%SW%" or footage from lines SE/4 SW/4 SE/4
Lease Owner Barbara Oil Company
Lease Name Evans Well No. 1
Office Address 509 Union Center Wichita, Kansas
Character of Well (completed as Oil, Gas or Dry Hole) Dry Hole
Date well completed: July 1, 1966 19
Application for plugging filed July 1, 1966 19
Application for plugging approved July 1, 1966 19
Plugging commenced July 1, 1966 19
Plugging completed July 1, 1966 19
Reason for abandonment of well or producing formation Dry

If a producing well is abandoned, date of last production _____ 19____
Was permission obtained from the Conservation Division or its agents before plugging was commenced? Yes

Name of Conservation Agent who supervised plugging of this well _____
Producing formation _____ Depth to top _____ Bottom _____ Total Depth of Well 3555 Feet
Show depth and thickness of all water, oil and gas formations.

OIL, GAS OR WATER RECORDS

CASING RECORD

FORMATION	CONTENT	FROM	TO	SIZE	PUT IN	PULLED OUT
				8-5/8"	219'	0

Describe in detail the manner in which the well was plugged, indicating where the mud fluid was placed and the method or methods used in introducing it into the hole. If cement or other plugs were used, state the character of same and depth placed, from _____ feet to _____ feet for each plug set.

Heavy mud to 210'. Plug at 210'. 1/2 sack hulls and 25 sacks cement through drill pipe. Heavy mud to 40'. Solid bridge at 40' and cement to base of cellar. Filled rat hole with cement. Plugging completed at 6:00 P.M.

RECEIVED
STATE CORPORATION COMMISSION

JUL 11 1966

CONSERVATION DIVISION
Wichita, Kansas

7-11-66

(If additional description is necessary, use BACK of this sheet)
Name of Plugging Contractor K & E Drilling, Inc.
Address 719 Union Center Building, Wichita, Kansas

STATE OF Kansas, COUNTY OF Sedgwick, ss.
Wayne L. Brinegar of K & E Drilling, Inc. (employee of owner) or (owner or operator) of the above-described well, being first duly sworn on oath, says: That I have knowledge of the facts, statements, and matters herein contained and the log of the above-described well as filed and that the same are true and correct. So help me God.

(Signature) Wayne L. Brinegar
Wayne L. Brinegar
719 Union Center, Wichita, Kansas
(Address)

SUBSCRIBED AND SWORN TO before me this 7th day of July, 1966

My commission expires 6-8-70

Judie Bickford
Judie Bickford
Notary Public.

15-155-30139-0000

DRILLER'S WELL LOG

OPERATOR: Barbara Oil Company

WELL NAME: #1 Evans

LOCATION: SE/4 SW/4 SE/4
Section 17-24S-7W
Reno County, Kansas

CONTRACTOR: **K & E DRILLING, INC.**
719 UNION CENTER BLDG.
K & E Drilling, Inc. WICHITA, KANSAS

COMMENCED: June 25, 1966

CASING RECORD:
8-5/8" @ 219'

COMPLETED: July 1, 1966

ROTARY TOTAL DEPTH: 3555'

ELEVATION: 1612' Gr; 1618' DF;
1621' KB

PRODUCTION: Dry Hole

FORMATION RECORD

Depths shown indicate bottom of formations encountered.

Clay	20
Sand	70
Shale	1090
Shale & Lime	1390
Lime	1585
Shale & Lime	1725
Lime	2125
Shale & Lime	2375
Lime	3555

RECEIVED
STATE CORPORATION COMPTROLLER

JUL 11 1966

CONSERVATION DIVISION
Wichita, Kansas

CERTIFICATION

State of KANSAS
County of SEDGWICK ss:

I, Wayne L. Brinegar, of K&E DRILLING, INC., upon oath state that the above and foregoing is a true and correct copy of the Driller's Log of the above-named well.

Subscribed and sworn to before me this 7th day of July, 1966

My Commission expires: 6-8-70

Wayne L. Brinegar
Wayne L. Brinegar
Judie Bickford
Judie Bickford Notary-Public.

