


WELL PLUGGING RECORD

Give All Information Completely
Make Required Affidavit
Mail or Deliver Report to:
Conservation Division
State Corporation Commission
800 Bitting Building
Wichita, Kansas

NORTH

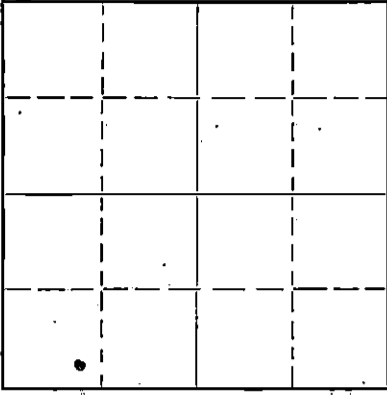

Locate well correctly on above
Section Plat

Barton County, Sec. 22 Twp. 16S Rge. (E) 11 (W)
Location as "NE/CNW $\frac{1}{4}$ /SW $\frac{1}{4}$ " or footage from lines 990' EWL and 330' NSL of SW $\frac{1}{4}$
Lease Owner Gulf Oil Corporation
Lease Name S. Besthorn Well No. 3
Office Address Box 661, Tulsa, Oklahoma
Character of Well (completed as Oil, Gas or Dry Hole) Dry Hole
Date well completed August 13 19 50
Application for plugging filed August 13 19 50
Application for plugging approved August 13 19 50
Plugging commenced August 14 19 50
Plugging completed August 15 19 50
Reason for abandonment of well or producing formation Dry Hole
If a producing well is abandoned, date of last production 19
Was permission obtained from the Conservation Division or its agents before plugging was commenced? Yes

Name of Conservation Agent who supervised plugging of this well Mr. C. D. Staugh
Producing formation Arbuckle Depth to top 3426' Bottom 3447' Total Depth of Well 3447' Feet
Show depth and thickness of all water, oil and gas formations.

OIL, GAS OR WATER RECORDS

CASING RECORD

Formation	Content	From	To	Size	Put In	Pulled Out
				10 - 3/4"	766'	None

Describe in detail the manner in which the well was plugged, indicating where the mud fluid was placed and the method or methods used in introducing it into the hole. If cement or other plugs were used, state the character of same and depth placed, from _____ feet to _____ feet for each plug set.

Hole filled with heavy mud from TD to 250 ft., pushed Howco plug to 250 ft. and spotted 20 sacks of cement through the drill pipe. Filled to 14 ft. with mud, placed bridge at 14 ft. and filled to bottom of collar with 5 sacks of cement.

RECEIVED
SEP 14 1950
9-1-50

(If additional description is necessary, use BACK of this sheet)


Correspondence regarding this well should be addressed to Gulf Oil Corporation, c/o S. G. Sanderson
Address Box 661,
Tulsa, Oklahoma

STATE OF Kansas, COUNTY OF Rice, ss.
H. H. Wright (employee of owner) or (owner or operator) of the above-described well,
being first duly sworn on oath, says: That I have knowledge of the facts, statements, and matters herein contained and the log of the above-described well as filed and that the same are true and correct. So help me God.

(Signature) H. H. Wright
Box 544, Chase, Kansas (Address)

SUBSCRIBED AND SWORN to before me this 17th day of August, 19 50

My commission expires April 14, 1952
M. M. Connell Notary Public.

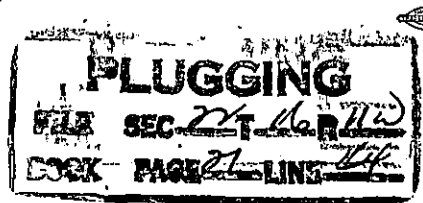

WELL RECORD

CULLET 880

15 909-05597-00-00

WELL NO. 3 LEASE Sophia Northern COMPANY Gulf Oil Corporation A.F.E. 2369

DATE—DRILLING BEGAN 7-31-50 ^{Plugging} WELL COMPLETED 8-15-50 FIRST PRODUCTION

SAND RECORD Top Arbuclie 3026' TOTAL DEPTH 3047'

INITIAL PRODUCTION Dry Hole - Plugged & Abandoned.

CASING RECORD

SIZE	WEIGHT	THD.	CLASS	MAKE	SET AT DEPTH	SACKS CEMENT	LBS. GAL. CHLO.	PULLED	LEFT IN
10-3/4"	32.25	8U	A	Gals.	966'	375	270		766'

S—22 T—165 R—114

0									

ELEVATION—1927'

DISTANCE II: From top collar to rotary washing is 10'.

FORMATION RECORD:

	From	To
Sand	0'	110'
Shale		505
Sand & iron		518
Shale & red bed		675
Red bed		750
Anhydrite		790
Red bed & shale		1065
Shale		1435
Lime & shale		1660
Shale & lime		1775
lime & shale		1850
Lime		1955
Shale & lime		2060
lime & shale		2290
Shale		2490
lime & chalu		2620
lime		2791
Shale & lime		3053
lime		3355
lime & shale		3385
lime, shale & chert		3424
lime		3447

TOTAL DEPTH

DATE 8-25-50

RECEIVED

STATE REGISTRATION COMMISSION KANSAS SEP 1 X 1950

PLUGGING
WELL SEC 27 T 16 R 114
DATE 1953 8 11