


WELL PLUGGING RECORD

Give All Information Completely  
Make Required Affidavit  
Mail or Deliver Report to:  
Conservation Division  
State Corporation Commission  
800 Bittling Building  
Wichita, Kansas

NORTH

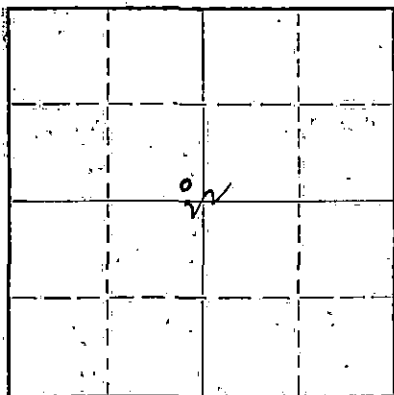

Locate well correctly on above Section Plat

Barton County, Sec. 22 Twp. 16 Rge. 11 (E) (W)  
Location as "NE/CNW4SW4" or footage from lines SE SE NW  
Lease Owner HONAKER DRILLING CO., INC.  
Lease Name Stumps Well No. 1  
Office Address Great Bend, Kansas  
Character of Well (completed as Oil, Gas or Dry Hole) Dry  
Date well completed September 28 19.50  
Application for plugging filed September 28 19.50  
Application for plugging approved September 28 19.50  
Plugging commenced 4 P.M. September 28 19.50  
Plugging completed 11 P.M. September 28 19.50  
Reason for abandonment of well or producing formation Dry

If a producing well is abandoned, date of last production 19.  
Was permission obtained from the Conservation Division or its agents before plugging was commenced? Yes

Name of Conservation Agent who supervised plugging of this well Mr. C. D. Stough  
Producing formation \*\*\*\*\* Depth to top \*\*\*\*\* Bottom \*\*\*\*\* Total Depth of Well 3374 Feet  
Show depth and thickness of all water, oil and gas formations.

OIL, GAS OR WATER RECORDS

CASING RECORD

Formation	Content	From	To	Size	Put In	Pulled Out

Describe in detail the manner in which the well was plugged, indicating where the mud fluid was placed and the method or methods used in introducing it into the hole. If cement or other plugs were used, state the character of same and depth placed, from \_\_\_\_\_ feet to \_\_\_\_\_ feet for each plug set.

Filled with mud, Plug set 243' 20 sacks cement mixed and pumped thru drill pipe, to 43'. Plug set 43'. 15 sacks cement to bottom of cellar.

11-22-50

RECEIVED  
STATE CORPORATION COMMISSION  
NOV 22 1950  
CONSERVATION DIVISION  
Wichita, Kansas

(If additional description is necessary, use BACK of this sheet)

Correspondence regarding this well should be addressed to HONAKER DRILLING CO., INC.  
Address Great Bend, Kansas

STATE OF KANSAS, COUNTY OF BARTON, ss:  
JOE J. HONAKER (employee of owner) or (owner or operator) of the above-described well,  
being first duly sworn on oath, says: That I have knowledge of the facts, statements, and matters herein contained and the log of the above-described well as filed and that the same are true and correct. So help me God.

(Signature) Joe J. Honaker  
Great Bend, Kan. (Address)

SUBSCRIBED AND SWORN to before me this 29<sup>th</sup> day of Sept, 19.50

My commission expires 9-1-54  
L. E. Caraway Notary Public.

PLUGGING  
FILE SEC 22T 16R 11W  
BOOK PAGE 31 LINE 36

15-009-008750000


WELL LOG BUREAU -- KANSAS GEOLOGICAL SOCIETY  
508 East Murdock, Wichita, Kansas

Company - HONAKER DRILLING  
Farm - Stumps No. 1

SEC. 22 T. 16 R. 11W  
SE SE NW

Total Depth. 3374  
Comm. 9-18-50 Comp. 9-29-50  
Shot or Treated.  
Contractor.  
Issued. 10-21-50

County. Ellis  
KANSAS

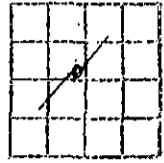

CASING:  
8 7/8" 244' cem w/125 sx.

Elevation. 1896

Production. dry

soil, lime	45
shale	55
shells	244
shale, shells	340
sand, shale	430
shale, shells	550
red rock, shale	732
anhydrite	748
shale, shells	1240
salt, shells	1270
shale, shells	1517
lime, shale	1570
lime	1625
shale, lime	1720
lime	1740
lime, shale	1770
lime	1950
lime, shale	2000
shale, shells	2595
shale sdy, shells	2654
lime, shale	2900
lime	2940
lime, shale	3110
lime	3315
shale, lime	3359
lime	3374
Total Depth	

Figures Indicate Bottom of Formations.

Tops:

Anhydrite	732
Heebner	2949
Brown Lime	3046
Kansas City	3066
Conglomerate	3353

RECEIVED  
STATE CORPORATION COMMISSION

NOV 22 1950

CONSERVATION DIVISION  
Wichita, Kansas

**PLUGGING**  
FILE SEC 22 T 16 R 11W  
BOOK PAGE 31 LINE 26