


STATE OF KANSAS
STATE CORPORATION COMMISSION

Give All Information Completely
Make Required Affidavit
Mail or Deliver Report to
Conservation Division
State Corporation Commission
245 North Water
Wichita, KS 67202

FORM CP-4

WELL PLUGGING RECORD

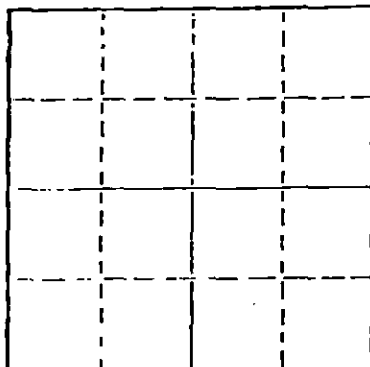

Locate well correctly on above Section Plat

Harvey County, Sec. 5 Twp. 24S Rge. 2 (EXX) (W)
Location as "NE/CNW/SE/SW" or footage from lines C SW/4 NE/4
Lease Owner John Jay Darrah
Lease Name Krehbiel Well No. 1
Office Address 1010 Century Plaza Bldg., Wichita, Kansas 67202
Character of Well (completed as Oil, Gas or Dry Hole) Dry
Date well completed December 10 1976
Application for plugging filed 19
Application for plugging approved 19
Plugging commenced 19
Plugging completed December 10, 1976
Reason for abandonment of well or producing formation Dry Hole

If a producing well is abandoned, date of last production 19
Was permission obtained from the Conservation Division or its agents before plugging was commenced? Yes

Name of Conservation Agent who supervised plugging of this well High Scott
Producing formation _____ Depth to top _____ Bottom _____ Total Depth of Well _____ feet
Show depth and thickness of all water, oil and gas formations.

OIL, GAS OR WATER RECORDS

12-15-76

CASING RECORD

FORMATION	CONTENT	FROM	TO	SIZE	PUT IN	PULLED OUT
Shale		0	30'	10 3/4"	30'	None
Sand		30	50'	10 3/4"	20'	None
Shale		50	85'	10 3/4"	35'	None
Sand		85	260'	10 3/4"	175'	None
Blue Shale		260'	293'	10 3/4"	33'	None

Describe in detail the manner in which the well was plugged, indicating where the mud fluid was placed and the method or methods used in introducing it into the hole. If cement or other plugs were used, state the character of same and depth placed, from _____ feet to _____ feet for each plug set.

Set bottom plug at 310' and cemented with 45 sacks of cement. Set top plug at 40' and cemented with 28 sacks of cement, 2 sacks in rathole. Plugging completed at 6:30 A. M., December 10, 1976 by State Plugger, High Scott, McPherson, Kansas

(If additional description is necessary, use BACK of this sheet)

Name of Plugging Contractor Blackstone Drilling, Inc.
Address Box 1184, McPherson, Kansas 67460

STATE OF Kansas COUNTY OF Sedgwick ss.
John J. Darrah (employee of owner) or (owner or operator) of the above-described

well, being first duly sworn on oath, says: That I have knowledge of the facts, statements, and matters herein contained and the log of the above-described well as filed and that the same are true and correct. So help me God.

(Signature) John Jay Darrah
1010 Century Plaza Bldg., Wichita, Ks.
(Address)

Subscribed and sworn to before me this 10th day of December, 1976

My commission expires Sept 24, 1979
Mona Stiller Notary Public



Blackstone Drilling, Inc.

Box 455 • 523 West Kansas • Phone (316) 241-1250
 McPHERSON, KANSAS 67460

December 10, 1976

COMPANY: JOHN JAY DARRAH
CONTRACTOR: BLACKSTONE DRILLING, INC.
FARM: KREHBIEL #1
LOCATION: C SW/4 NE/4, Section 5-248-2W, Harvey County, Kansas
COMMENCED: November 30, 1976
COMPLETED: December 10, 1976
ELEVATION:

0	to	30	Shale
30	to	50	Sand
50	to	85	Shale
85	to	260	Sand
260	to	300	Blue Shale
300	to	475	Shale
475	to	915	Shale & Lime
915	to	1075	Lime & Shale
1075	to	1290	Shale
1290	to	1740	Shale & Lime
1740	to	1915	Lime & Shale
1915	to	1980	Lime
1980	to	2175	Lime & Shale
2175	to	2590	Shale & Lime
2590	to	3105	Lime
3105	to	3205	Lime & Shale
3205	to	3310	Shale & Lime
3310	to	3320	Mississippi
3320	to	3410	Lime
3410	to	3662	Mississippi
3662	to	3715	Lime
3715	to	3840	Mississippi
		3840	T. D.

RECEIVED
 DEPARTMENT OF REVENUE
 CONSERVATION DIVISION
 McPherson, Kansas

Cut 15" hole to 291' and run 293' of 10 3/4 inch surface pipe, cemented with 200 sacks of cement at 291'. Plug down at 3:00 P. M., December 1, 1976. Hole dry and abandoned. Set bottom plug at 310' and cemented with 45 sacks of cement. Set top plug at 40' & cemented with 28 sacks of cement. 2 sacks in rat hole. Plugging completed at 6:30 A. M. December 10, 1976 by State Plugger, Hugh Scott, McPherson, Kansas.

TOPS:
 Measurements taken from K. B.

CERTIFICATE

I, P. E. Plouffe, President of Blackstone Drilling, Inc. do hereby certify that the above and foregoing is a true and correct copy of log on your Krehbiel #1, located on the C SW/4 NE/4, Section 5-248-2W, Harvey County, Kansas as reflected by the files of Blackstone Drilling, Inc.

P. E. Plouffe
 P. E. Plouffe, President

Subscribed and sworn to before me a Notary Public in and for McPherson County, Kansas this 10th day of December, 1976.

JOHNNIE L. SCHMIDT
 McPherson County, Kansas
 My Comm. Exp. June 23, 1977

Johnnie L. Schmidt
 Johnnie L. Schmidt - Notary Public