

STATE OF KANSAS
STATE CORPORATION COMMISSION


WELL PLUGGING RECORD

OR
FORMATION PLUGGING RECORD

Strike out upper line when reporting plugging of formations.

Give All Information Completely
Make Required Affidavit
Mail or Deliver Report to:
Conservation Division
State Corporation Commission
800 Bitting Building
Wichita, Kansas

NORTH

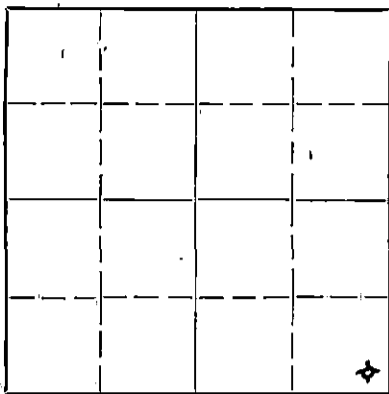

Locate well correctly on above Section Plat

Harvey County, Sec. 15 Twp. 24 Rge. 2 (W) est
Location as "NE1/4NW1/4SW1/4" or footage from lines C. SE/4 SE/4 SE/4
Lease Owner The Derby Oil Company and Sunray Oil Company
Lease Name Webster Well No. 1
Office Address Wichita, Kansas
Character of Well (completed as Oil, Gas or Dry Hole) Dry Hole
Date well completed September 6 19 43
Application for plugging filed September 7 19 43
Application for plugging approved September 7 19 43
Plugging commenced September 7 19 43
Plugging completed September 7 19 43
Reason for abandonment of well or producing formation Dry Hole
If a producing well is abandoned, date of last production 19
Was permission obtained from the Conservation Division or its agents before plugging was commenced? Yes

Name of Conservation Agent who supervised plugging of this well Ruel Durkee
Producing formation Arbuckle (Dry) Depth to top 3942' Bottom 3995' Total Depth of Well 3995' Feet
Show depth and thickness of all water, oil and gas formations.

OIL, GAS OR WATER RECORDS

CASING RECORD

Formation	Content	From	To	Size	Put In	Pulled Out
				8-5/8"	803	None

Describe in detail the manner in which the well was plugged, indicating where the mud fluid was placed and the method or methods used in introducing it into the hold. If cement or other plugs were used, state the character of same and depth placed, from feet to feet for each plug set.

3995' to 360' Mud
360' to 357' Wood Plug
357' to 295' Cement
295' to 40' Mud
40' to 37' Wood Plug
37' to 32' Crushed Rock
32' to 5' Cement
5' to Surface - Earth

9-16-43

PLUGGING
FILE 15 24 24
BOOK PAGE 20 LINE 36

(If additional description is necessary, use BACK of this sheet)

Correspondence regarding this well should be addressed to The Derby Oil Company
Address Wichita, Kansas

STATE OF Kansas COUNTY OF Sedgwick, ss.
S.E. Banks (employee of owner) or (owner or operator) of the above-described well,
being first duly sworn on oath, says: That I have knowledge of the facts, statements, and matters herein contained and the log of the above-described well as filed and that the same are true and correct. So help me God.

(Signature) S.E. Banks
Wichita, Kansas
(Address)

SUBSCRIBED AND SWORN TO before me this 14th day of September, 19 43

My commission expires 7/31/47

[Signature]
Notary Public.

THE DERBY OIL COMPANY

Record of Well No. 1 Webster Farm
 Location SE/c Sec. 15 Twp. 24 Rge. 2W
 Contractor Crow Drilling Company County Harvey
 Drilling commenced 8-10-43 State Kansas
 Elevation Est. 1394 Drilling completed 9-6-43

Casing Record

Size	Feet	Kind	Weight
8 5/8"	803'	Surface	300 sax Regular Cement & 2 sax Aquagel

Formation	Bottom	Formation	Bottom
Sand	0-95	Lime	2945
Sand & shale strks.	112	Lime & shale streaks	2955
Sand	133	Lime & shale	3098
Gravel & sand	155	Shale	3117
Shale (dark)	300	Shale & lime	3237
Shale & shells	415	Lime	3241
Anhydrite	448	Shale & lime	3323
Lime & shale	480	Broken lime	3343
Broken lime, shale & Anhydrite	575	Lime & shale	3351
Anhydrite & lime	635	Chat	3585
Anhydrite, lime & shale	705	Chat & shale	3611
Anhydrite & shale	754	Chat	3668
Lime & shale	900	Chat & shale	3688
Cherty lime	911	Chat	3709
Broken lime	951	Shale & lime	3839
Sandy lime	981	Shale	3845
Broken lime	1019	Lime	3885
Lime & shale	1110	Sand & lime	3957
Broken lime	1140	Lime	3995
Shale & shells	1210		T.D.
Shale & lime strks.	1325		
Sandy shale	1375		
Shale, shells & sand streaks	1448		
Shale	1510		
Shale & shells	1610		
Lime & shale	1998		
Lime	2126		
Lime & shale	2142		
Lime	2243		
Lime & shale	2440		
Sandy shale	2461		
Lime	2662		
Sandy lime (soft)	2677		
Cherty lime	2712		
Lime	2784		
Lime & shale	2812		
Lime	2835		
Cherty lime	2840		
Shale & lime	2858		

GEOLOGICAL DATA

Tops:
 Miss. 3322
 Viola 3842
 Simp. 3857
 Arb. 3942
 T.D. 3995

show oil 3884-89

D & A

LOG 15 24 20
 90 36