


WELL PLUGGING RECORD

Give All Information Completely  
Make Required Affidavit  
Mail or Deliver Report to:  
Conservation Division  
State Corporation Commission  
212 North Market, Insurance Bldg.  
Wichita, Kansas

Harvey County. Sec. 15 Twp. 24S Rge. 2W (X) (W)  
Location as "NE/CNW/SW" or footage from lines SW 1/4 SW 1/4 NW 1/4  
Lease Owner Leben Drilling, Inc.  
Lease Name Webster Well No. 1  
Office Address 905 Central Bldg., Wichita, Kansas  
Character of Well (completed as Oil, Gas or Dry Hole) Dry Hole  
Date well completed 1-23-59 19  
Application for plugging filed 1-23-59 19  
Application for plugging approved 1-23-59 19  
Plugging commenced 1-23-59 19  
Plugging completed 1-23-59 19  
Reason for abandonment of well or producing formation Dry Hole

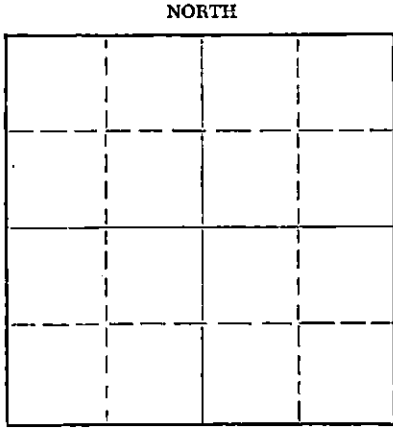

Locate well correctly on above  
Section Plat

If a producing well is abandoned, date of last production -- 19  
Was permission obtained from the Conservation Division or its agents before plugging was commenced? yes

Name of Conservation Agent who supervised plugging of this well Eugene Graham  
Producing formation \_\_\_\_\_ Depth to top \_\_\_\_\_ Bottom \_\_\_\_\_ Total Depth of Well 3985 Feet  
Show depth and thickness of all water, oil and gas formations.

OIL, GAS OR WATER RECORDS

CASING RECORD

FORMATION	CONTENT	FROM	TO	SIZE	PUT IN	PULLED OUT
				8 5/8"	408'	

Describe in detail the manner in which the well was plugged, indicating where the mud fluid was placed and the method or methods used in introducing it into the hole. If cement or other plugs were used, state the character of same and depth placed, from \_\_\_\_\_ feet to \_\_\_\_\_ feet for each plug set.

Filled with heavy mud to 240',  
first plug @ 240' w/20 sacks cement & 1/4 sack hulls  
second plug @ 40' w/10 sacks cement & 1/4 sack hulls

2-7-59

RECEIVED  
STATE CORPORATION COMMISSION  
FEB 7 1959  
CONSERVATION DIVISION  
Wichita, K.

(If additional description is necessary, use BACK of this sheet)

Name of Plugging Contractor Leben Drilling, Inc.  
Address 905 Central Bldg., Wichita, Kansas

STATE OF Kansas, COUNTY OF Sedgwick, ss.  
L. Frank Hamlin (employee of owner) or (owner or operator) of the above-described well, being first duly sworn on oath, says: That I have knowledge of the facts, statements, and matters herein contained and the log of the above-described well as filed and that the same are true and correct. So help me God.

(Signature) Frank Hamlin  
905 Central Bldg., Wichita, Kansas  
(Address)

SUBSCRIBED AND SWORN TO before me this 26th day of January, 19 59

My commission expired June 17, 1961  
Ruth N. Benjamin Notary Public.

PLUGGING  
FILE SEC. 15 T. 24 R. 2W  
BOOK PAGE 13 LINE 40

DRILLER'S LOG

COMPANY: **LEBEN DRILLING, INC.**  
 CONTRACTOR: **LEBEN DRILLING, INC.**  
 FARM: **WEBSTER #1**  
 LOCATION: **NW 1/4 SW 1/4 NW 1/4 SEC. 15-24S-2W HARVEY COUNTY, KANSAS**  
 COMMENCED: **1-6-59**  
 COMPLETED: **1-23-59**

0	70	Sand	
70	395	Sand & Shale	
395	470	Anhydrite	<u>LOG TOPS:</u>
470	590	Shale & Lime	Latan
590	2465	Shale & Lime	Lansing
2465	2745	Lime	Base K.C.
2745	2815	Lime	Mississippian
2815	2905	Lime & Shale	Kinderhook Sh.
2905	3220	Lime	Hunton
3220	3270	Shale, Lime & Chert	Maquoketa Sh.
3270	3402	Lime & Shale	Viola
3402	3433	Shale, Lime & Chert	Simpson Dolo.
3433	3583	Lime	Simpson Sand
3583	3621	Chert & Lime	Arbuckle
3621	3670	Lime	Elevation
3670	3697	Lime, Shale & Chert	1402 K.B.
3697	3927	Lime	
3927	3963	Lime, Shale & Sand	
3963	3985	Dolomite	
	3985	Rotary Total Depth	D & A

I, Frank Hamlin, do hereby certify that the above and foregoing is a true and correct copy of the log of the Webster #1, located SW 1/4 SW 1/4 NW 1/4 of Section 15, Township 24 South, Range 2 West, Harvey County, Kansas, as reflected by the files of Leben Drilling, Inc.

*Frank Hamlin*  
 Frank Hamlin - Geologist

Set 8 5/8" surface casing @ 400' with 325 sacks cement & 2% CaCl.

STATE OF KANSAS )  
 COUNTY OF SEDGWICK ) ss:

Subscribed and sworn to before me, a Notary Public, in and for Sedgwick County, Kansas, this 2nd day of February, 1959

*Ruth N. Benjamin*  
 Ruth N. Benjamin, Notary Public

My commission expires:  
 June 17, 1961

PLUGGING  
 FILE SEC. 15 T. 24 R. 2W  
 BOOK PAGE 13 LINE 40