


WELL PLUGGING RECORD

Give All Information Completely  
Make Required Affidavit  
Mail or Deliver Report to:  
Conservation Division  
State Corporation Commission  
212 North Market, Insurance Bldg.  
Wichita, Kansas

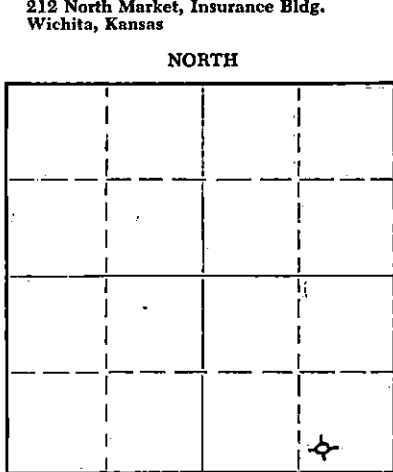

Locate well correctly on above Section Plat

Harvey County. Sec. 1 Twp. 24S Rge. 3 (E) W (W)  
Location as "NE/CNW/SW" or footage from lines SW/4 SE/4 SE/4  
Lease Owner Kewanee Oil Company  
Lease Name Richter Well No. 1  
Office Address 548 Petroleum Bldg., Wichita, Kansas  
Character of Well (completed as Oil, Gas or Dry Hole) Dry Hole  
Date well completed June 1, 19 60  
Application for plugging filed (verbal) June 2, 19 60  
Application for plugging approved (verbal) June 2, 19 60  
Plugging commenced June 2, 19 60  
Plugging completed June 2, 19 60  
Reason for abandonment of well or producing formation Dry Hole

If a producing well is abandoned, date of last production 19  
Was permission obtained from the Conservation Division or its agents before plugging was commenced? Yes

Name of Conservation Agent who supervised plugging of this well STATE PLUGGER - Cecil Jones  
Producing formation Depth to top Bottom Total Depth of Well 4015 Feet  
Show depth and thickness of all water, oil and gas formations.

OIL, GAS OR WATER RECORDS

CASING RECORD

FORMATION	CONTENT	FROM	TO	SIZE	PUT IN	PULLED OUT
		0	509'	8-5/8"	509'	none

Describe in detail the manner in which the well was plugged, indicating where the mud fluid was placed and the method or methods used in introducing it into the hole. If cement or other plugs were used, state the character of same and depth placed, from feet to feet for each plug set.

Bottom plug set at 240' with 1/2 sack hulls and 20 sacks cement.  
Top plug set at 35' with 1/2 sack hulls and 10 sacks cement.

RECEIVED  
STATE CORPORATION COMMISSION

JUN 9 1960

CONSERVATION DIVISION  
Wichita, Kansas

(If additional description is necessary, use BACK of this sheet)  
Name of Plugging Contractor Birmingham-Bartlett Drilling Co.  
Address 300 Kaufman Building, Wichita 2, Kansas

STATE OF Kansas COUNTY OF Sedgwick  
Richard Hindery, partner of Birmingham-Bartlett Drilling Co., Contractor  
(employee of owner) or (owner or operator) of the above-described well, being first duly sworn on oath, says: That I have knowledge of the facts, statements, and matters herein contained and the log of the above-described well as filed and that the same are true and correct. So help me God. BIRMINGHAM-BARTLETT DRILLING CO.  
(Signature) By Richard Hindery Partner  
300 Kaufman Bldg., Wichita 2, Kansas (Address)

SUBSCRIBED AND SWORN TO before me this 3rd day of June, 19 60.

My commission expires October 2, 1962. Beverly Larson Notary Public.



RICHTER NO. 1 WELL

LOCATION: SW/4 SE/4 SE/4  
 Section 1-24S-3W  
 Harvey County, Kansas

SPUDED: 5-19-60  
 COMPLETED: 6-1-60

OPERATOR: Kewanee Oil Company  
 548 Petroleum Building  
 Wichita, Kansas

CONTRACTOR: Birmingham-Bartlett Drilling Co.  
 300 Kaufman Building  
 Wichita 2, Kansas

SURFACE CASING: 8-5/8" cemented at 509' with  
 450 sacks cement and 4 c.c.

OIL STRING: None set. Plugging completed  
 on 6-2-60.

L O G

(Figures indicate bottom of formation)

0	-	150	Sand
		250	Clay and sand
		493	Shale and shells
		516	Anhydrite
		2270	Shale and lime
		2438	Lime
		2670	Shale and lime
		2927	Lime
		3150	Lime and shale
		3217	Lime
		3423	Lime and shale
		3510	Lime
		3580	Lime and shale
		3726	Lime
		3880	Lime and shale
		3915	Lime
		3985	Lime and shale
		4015	Lime
		4015	Rotary total depth

**RECEIVED**  
 STATE CORPORATION COMMISSION

JUN 9 1960

CONSERVATION DIVISION  
 Wichita, Kansas

The undersigned, Richard Hindery, one of the partners of Birmingham-Bartlett Drilling Co., hereby certifies that the above is a true and correct log of the formations encountered in drilling the Richter No. 1 Well as shown in the daily drilling reports.

BIRMINGHAM-BARTLETT DRILLING CO.

By Richard Hindery  
 Richard Hindery, Partner

Subscribed and sworn to before me  
 this 3rd day of June, 1960.

Beverly Larson  
 Beverly Larson, Notary Public  
 My commission expires October 2, 1962.