

WELL PLUGGING RECORD

Give All Information Completely  
Make Required Affidavit  
Mail or Deliver Report to:  
Conservation Division  
State Corporation Commission  
212 North Market, Insurance Bldg.  
Wichita, Kansas

HARVEY

County, Sec. 8 Twp. 24S Rge. (E) 3 (W)

Location as "NE/CNWxSWx" or footage from lines SE SE NE

Lease Owner Cities Service Oil Company

Lease Name Mc New

Well No. 1

Office Address Box 31, Augusta, Kansas

Character of Well (completed as Oil, Gas or Dry Hole) Dry Hole

Date well completed 9-23 19 59

Application for plugging filed 9-24 19 59

Application for plugging approved 9-30 19 59


Plugging commenced 9-24 19 59

Plugging completed 9-24 19 59

Reason for abandonment of well or producing formation Dry Hole

If a producing well is abandoned, date of last production 19

Was permission obtained from the Conservation Division or its agents before plugging was commenced? Yes

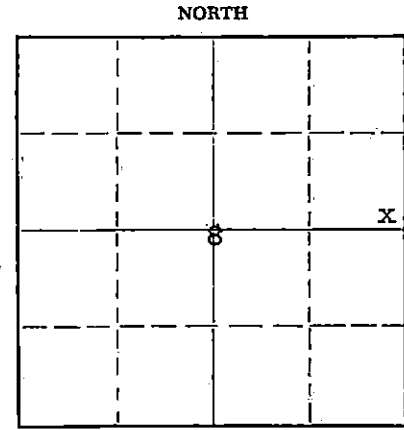

Locate well correctly on above Section Plat

Name of Conservation Agent who supervised plugging of this well Cecil Jones

Producing formation Depth to top Bottom Total Depth of Well 4030' Feet

Show depth and thickness of all water, oil and gas formations.

OIL, GAS OR WATER RECORDS

CASING RECORD

FORMATION	CONTENT	FROM	TO	SIZE	PUT IN	PULLED OUT
See Log Attached				10 3/4"	530'	NONE

Describe in detail the manner in which the well was plugged, indicating where the mud fluid was placed and the method or methods used in introducing it into the hole. If cement or other plugs were used, state the character of same and depth placed, from feet to feet for each plug set.

Heavy mud 4030' to 300', wood plug set at 300', Halls and cement 300' to 260', heavy mud 260' to 30', wood plug set at 30', cement 30' to surface

10-10-59

RECEIVED  
STATE CORPORATION COMMISSION

OCT 10 1959

CONSERVATION DIVISION  
Wichita, Kansas

(If additional description is necessary, use BACK of this sheet)

Name of Plugging Contractor White & Ellis Drilling Co.

Address Box 448, El Dorado, Kansas

STATE OF KANSAS, COUNTY OF BUTLER, ss.  
E. W. PETERMAN (employee of owner) or (owner or operator) of the above-described

well, being first duly sworn on oath, says: That I have knowledge of the facts, statements, and matters herein contained and the log of the above-described well as filed and that the same are true and correct. So help me God.

(Signature) E. W. Peterman

BOX 31, AUGUSTA, KANSAS  
(Address)

SUBSCRIBED AND SWORN to before me this 7 th day of October, 1959

Glenn R. Carmack

Notary Public.

My commission expires March 12, 1960



Casing Record

10 3/4

530<sup>0</sup> cemented  
w/500 sacks

Location: C SE SE NE  
Section 8-24S-3W  
Harvey County, Kansas  
Farm: McNew #1  
Well Owner: Cities Service Oil Co.  
Contractor: White & Ellis Drilling  
Started: 9-8-59  
Completed: 9-24-59

T. D.

4030<sup>0</sup>

Kelly Bushing measurement 5<sup>0</sup> above ground level

FORMATION DEPTH figures indicates bottom of formation

Sand	0-95		
Sand & Gravel, Shale	175	Lime	4030
Shale & Sand & Salt stks.	265		
Shale & Lime (shells)	360		
Lime	390		
Antihydrite	430		
Lime	605	TOPS	
Lime & Shale stks.	670		
Shale & Lime	725	Brown	2581
Shale & Shells	765		
Lime, sandy	795	Lansing	2604
Red Rock	815		
Shale, sandy	840	B/Kansas City	3065
Lime & Shale	1140		
Shale & Lime stks.	1235	Mississippi	3384
Lime & Shale	1360		
Shale & Shells	1645	Kinderhook	3768
Lime & Shale stks.	1745		
Lime & Shale	1795	Hunton	3786
Shale	1880		
Lime	1950	Viola	3890
Shale	2006		
Lime	2072	Simpson	3912
Shale	2095		
Lime & Shale stks.	2155	Arbuckle	3998
Shale, sandy	2202		
Lime & Shale stks.	2360		
Lime & Shale	2448		
Sandy Shale	2555	Dry Hole	
Lime	2559	Plugged & Abandoned	
Shale	2581		
Lime	2590		
Shale	2604		
Lime	3065		
Lmy, Shale & Lime	3112		
Lime	3183		
Shale & Lime	3290		
Shale	3324		
Lime	3348		
Shale	3384		
Lime	3609		
Lime & Chert	3618		
Lime	3768		
Shale	3786		
Chert & Lime	3800		
Lime	3805		
Shale	3890		
Lime	3912		
Sand	3991		
Sand & Shale	3998		