


WELL PLUGGING RECORD

Give All Information Completely
Make Required Affidavit
Mail or Deliver Report to:
Conservation Division
State Corporation Commission
211 No. Broadway
Wichita, Kansas

NORTH

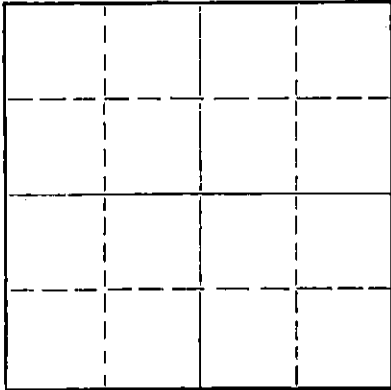

Locate well correctly on above
Section Plat

Russell County, Sec. 11 Twp. 15 Rge. 12 (E) (W)
Location as "NE/CNWxSWx" or footage from lines NE NE
Lease Owner Fred and Philip Anschutz
Lease Name Ney Well No. 1
Office Address 1521 Wichita Plaza, Wichita, Kansas
Character of Well (completed as Oil, Gas or Dry Hole) Dry hole
Date well completed 7-11-64
Application for plugging filed 7-11 19 64
Application for plugging approved 7-11 19 64
Plugging commenced 7-11 19 64
Plugging completed 7-11 19 64
Reason for abandonment of well or producing formation None

If a producing well is abandoned, date of last production 19
Was permission obtained from the Conservation Division or its agents before plugging was commenced? Yes

Name of Conservation Agent who supervised plugging of this well Don Truan
Producing formation Depth to top Bottom Total Depth of Well 3364 Feet
Show depth and thickness of all water, oil and gas formations.

OIL, GAS OR WATER RECORDS

CASING RECORD

FORMATION	CONTENT	FROM	TO	SIZE	PUT IN	PULLED OUT
		0	196	8 5/8	196	-0-

Describe in detail the manner in which the well was plugged, indicating where the mud fluid was placed and the method or methods used in introducing it into the hole. If cement or other plugs were used, state the character of same and depth placed, from feet to feet for each plug set.

Filled hole with mud to 200',
plug, 1/3 sk. hulls, 25 sks. cement.
Mud to 40', plug, 1/3 sk. hulls, 10 sks. cement.
25 sks. cement in rat hole.

RECEIVED
STATE CORPORATION COMMISSION

JUL 20 1964

CONSERVATION DIVISION
Wichita, Kansas

(If additional description is necessary, use BACK of this sheet)

Name of Plugging Contractor Terrel Drilling and Producing
Address Box 606, Russell, Kansas

STATE OF KANSAS, COUNTY OF RUSSELL, ss.
Joe K. Branum (employee of owner) or (owner or operator) of the above-described

well, being first duly sworn on oath, says: That I have knowledge of the facts, statements, and matters herein contained and the log of the above-described well as filed and that the same are true and correct. So help me God.

(Signature) Joe K. Branum
Russell, Kansas (Address)

SUBSCRIBED AND SWORN to before me this 15th day of July, 19 64

My commission expires 12-12-66

Notary Public.

13-167-006-17.00-01

RECEIVED
STATE CORPORATION COMMISSION

JUL 20 1964

CONSERVATION DIVISION
Wichita, Kansas

W E L L L O G

OPERATOR: Fred B. Anschutz
1521 Wichita Plaza
Wichita, Kansas

CONTRACTOR: Terrel Drilling & Producing
Box 606
Russell, Kansas

LEASE: Ney #1

COMMENCED: July 3, 1964

LOCATION: NE NE Sec. 11-15S-12W
Russell County, Kansas

COMPLETED: July 11, 1964

DEPTHS & FORMATIONS

Post Rock	200	Lime	2888
Shale & Red Bed	700	Lime & Shale	2935
Shale	1405	Shale & Lime	2980
Shale & Lime	1595	Lime & Shale	3070
Lime & Shale	2050	Lime	3339
Shale & Lime	2633	Arbuckle	3355
Lime & Shale	2815	Lime (R.T.D.)	3364

STATE OF KANSAS)
)
COUNTY OF RUSSELL)

Joe K. Branum, owner of Terrel Drilling and Producing, being first duly sworn on oath says: "That I have knowledge of the facts, statements and matters herein contained and the log of the above described well as filed and that the same are true and correct."

Joe K. Branum
Joe K. Branum - TERREL DRILLING & PRODUCING

Subscribed and sworn before me this 15th day of July, 1964.

L. L. Simpson
Notary Public

My Commission Expires December 12, 1966.