


STATE OF KANSAS
STATE CORPORATION COMMISSION

WELL PLUGGING RECORD

Give All Information Completely
Make Required Affidavit
Mail or Deliver Report to:
Conservation Division
State Corporation Commission
211 No. Broadway
Wichita, Kansas

Russell County. Sec. 35 Twp. 15 Rge. 11 (E) 11 (W)

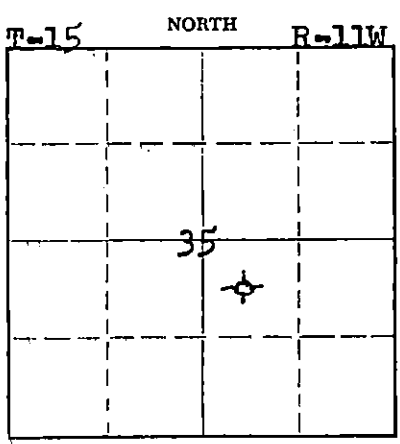

Location as "NE/CNW/SW" or footage from lines NW SE
Lease Owner Donald T. Ingling et al
Lease Name Renc Well No. 1
Office Address 615 First Nat'l Bldg., Wichita 2, Kansas
Character of Well (completed as Oil, Gas or Dry Hole) Dry Hole
Date well completed July 2, 1963
Application for plugging filed July 2, 1963
Application for plugging approved July 2, 1963
Plugging commenced July 2, 1963
Plugging completed July 2, 1963
Reason for abandonment of well or producing formation dry

If a producing well is abandoned, date of last production _____ 19____
Was permission obtained from the Conservation Division or its agents before plugging was commenced? Yes

Name of Conservation Agent who supervised plugging of this well Donald Truan
Producing formation _____ Depth to top _____ Bottom _____ Total Depth of Well 3373 Feet
Show depth and thickness of all water, oil and gas formations.

OIL, GAS OR WATER RECORDS CASING RECORD

FORMATION	CONTENT	FROM	TO	SIZE	PUT IN	PULLED OUT
				8 5/8"	325'	None

Describe in detail the manner in which the well was plugged, indicating where the mud fluid was placed and the method or methods used in introducing it into the hole. If cement or other plugs were used, state the character of same and depth placed, from _____ feet to _____ feet for each plug set.

Lay down drill pipe - set bridge at 300 feet - cemented through drill pipe with 25 sacks cement - filled hole to within 40 feet - plug at 40 feet then 10 sacks cement - 2 sacks cement in rathole.

RECEIVED
STATE CORPORATION COMMISSION

JUL 9 1963

CONSERVATION DIVISION
Wichita, Kansas

(If additional description is necessary, use BACK of this sheet)

Name of Plugging Contractor Donald T. Ingling
Address 615 First National Bldg., Wichita 2, Kansas

STATE OF KANSAS, COUNTY OF SEDGWICK, ss.
D. T. Ingling (employee of owner) or (owner or operator) of the above-described well, being first duly sworn on oath, says: That I have knowledge of the facts, statements, and matters herein contained and the log of the above-described well as filed and that the same are true and correct. So help me God.

(Signature) [Signature]
615 First Nat'l Bldg., Wichita 2, Kans
(Address)

Subscribed and sworn to before me this 8th day of July 1963

My commission expires Feb. 27, 1964 [Signature] Notary Public.

WELL LOG - RENC NO. 1

Donald T. Ingling et al, Lease Owner
Donald T. Ingling, Contractor
Commenced: 6-22-63
Completed: 7-2-63
Total Depth: 3373' (rotary)
Casing: 8 5/8" 325' (175 sacks cement)

Section 35-15-11W
Location: NW SE
County: Russell
Production: Dry
Elevation: 1838 RB

Figures below indicate bottom formation

90	surface rock and shale streaks	3260	lime and shale streaks
190	lime and shale streaks	3318	lime and shale
210	sand	3340	lime, Conglomerate and sand
240	lime and shale streaks	3353	Arbuckle - Top
584	lime and shale streaks	3373	lime and Conglomerate
700	shale and shells	3373	Total Depth
940	shale and shells		
990	lime and shale		
1155	shale and shells		
1398	shale and silt		
1510	lime and shale		
1725	lime and shale		
1815	lime		
1960	lime and shale streaks		
2050	lime and shale streaks		
2060	lime and shale		
2160	lime and shale		
2190	shale and shells		
2300	shale and lime streaks		
2435	shale and lime streaks		
2575	shale		
2675	lime and shale streaks		
2755	shale and lime		
2850	lime		
2915	lime and shale		
2980	Brown Lime - Top		
2985	lime and shale		
2993	shale		
3020	lime - Kansas City		
3085	lime		
3125	lime		
3195	lime		

RECEIVED
STATE CORPORATION COMMISSION

JUL 9 1963

CONSERVATION DIVISION
Wichita, Kansas

I certify this is a true and correct copy of the above mentioned well.

STATE OF KANSAS)
) ss.
SEDGWICK COUNTY 0

Donald T. Ingling

Subscribed and sworn to before me, a Notary Public, in said county and state.

My commission expires: Feb. 27, 1964

M. E. Black
Notary Public