


STATE OF KANSAS
STATE CORPORATION COMMISSION

WELL PLUGGING RECORD

Give All Information Completely
Make Required Affidavit
Mail or Deliver Report to
Conservation Division
State Corporation Comm.
245 North Water
Wichita, KS 67202

Stafford County, Sec. 331 Twp. 24 Rge. 12 E(W)
Location as "NE/CNW 1/4 SW 1/4" or footage from lines
NW SE of NE

Lease Owner F&M Oil Co., Inc
Lease Name Jenkins Well No. #1
Office Address 505 Union Center/Wichita, KS 67202
Character of Well (Completed as Oil, Gas or Dry Hole) Dry Hole

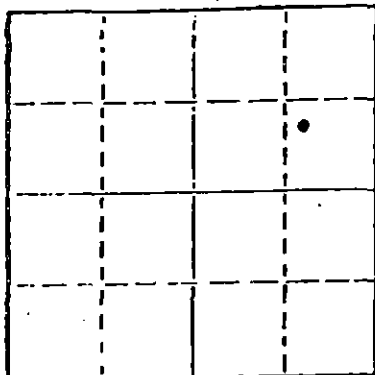

Locate well correctly on above
Section Plat

Date Well completed 5-18-77 19
Application for plugging filed 5-18-77 19
Application for plugging approved 5-18-77 19
Plugging commenced 5-18-77 19
Plugging completed 5-18-77 19
Reason for abandonment of well or producing formation Dry Hole

If a producing well is abandoned, date of last production
--- 19

Was permission obtained from the Conservation Division or
its agents before plugging was commenced? yes

Name of Conservation Agent who supervised plugging of this well J.H. Metz
Producing formation --- Depth to top --- Bottom --- Total Depth of Well 4180'
Show depth and thickness of all water, oil and gas formations.

OIL, GAS OR WATER RECORDS

CASING RECORD

FORMATION	CONTENT	FROM	TO	SIZE	PUT IN	PULLED OUT
			4180'	8 5/8"	302'	none

Describe in detail the manner in which the well was plugged, indicating where the mud fluid was placed and the method or methods used in introducing it into the hold. If cement or other plugs were used, state the character of same and depth placed, from --- feet to --- feet for each plug set.

Plugged with 35 sacks common cement @ 300'
15 sacks common cement @ 40',
5 sacks common cement in rathole.
By Allied Cementing job complete @ 8:30 A.M.

(If additional description is necessary, use BACK of this sheet)

Name of Plugging Contractor Allen Drilling Company

STATE OF Kansas COUNTY OF Barton ss.
Earl Allen (employee of owner) or (owner or operator) of the above-described

well, being first duly sworn on oath, says: That I have knowledge of the facts, statements, and matters herein contained and the log of the above-described well as filed and that the same are true and correct. So help me God.

(Signature) Earl Allen
P.O. Box 1389/Great Bend, KS 67530
(Address)

Subscribed and sworn to before me this 18th day of May, 19 77

My commission expires 11-25-79 Lavelta M. Murrishan Notary Public.



RECEIVED
STATE CORPORATION COMMISSION

JUN 02 1977 6-2-1977

CONSERVATION DIVISION
Wichita, Kansas

DRILLER'S WELL LOG

DATE COMMENCED: 5-9-77
 DATE COMPLETED: 5-18-77

F & M Oil Co., Inc.
 #1 Jenkins
 NW SE NE
 31-24s-12w
 Stafford, County Kansas

ELEVATIONS K.B. 1906'
 G.L. 1900'

0- 303' Lime & shale
 303- 725' Sand & Shale
 725- 742' ANHYDRITE
 742-3380' Sand & Shale
 3380-3417' Shale
 3417-3532' Shale
 3532-3562' Lime & Shale
 3562-3835' Lime
 3835-3960' Lime & Shale
 3960-4091' Chert
 4091-4156' Sand
 4156-4180' Dolomite
 4180' Log TD

FORMATION DATA

Log Tops
 Anhydrite 725
 Heebner 3380 -1474
 Douglas 3417 -1511
 Brown Lime 3532 -1626
 Lansing 3562 -1656
 Base KC 3835 -1929
 Viola 3960 -2054
 Simpson 4091 -2185
 ARB 4156 -2250
 Log TD 4180 -2274

SURFACE PIPE:

Ran 7 joints used 28# 8 5/8" casing set @ 302' with 250 sacks common, 2% gel, 3% cc by Allied. Plug down @ 3:45 A.M. Cement did circulate.

PLUGGING:

Plugged with 35 sacks Common @ 300', 15 sacks Common @ 40', 5 sacks Common in rathole, Job completed @ 8:30 A.M., By Allied Cementing.

AFFIDAVIT

STATE OF KANSAS)
 COUNTY OF BARTON) ss.

Earl Allen, of lawful age, does swear and state that the facts and statements herein contained are true and correct to the best of his knowledge.

Earl Allen

Subscribed and sworn to before me this 24th day of May 1977.

Lavelta M. Murnahan
 (Notary Public)

RECEIVED
 STATE CORPORATION COMMISSION

JUN 02 1977

CONSERVATION DIVISION
 Wichita, Kansas

My commission Expires: 11-25-79

