


STATE OF KANSAS  
STATE CORPORATION COMMISSION

WELL PLUGGING RECORD

Give All Information Completely  
Make Required Affidavit  
Mail or Deliver Report to  
Conservation Division  
State Corporation Comm.  
245 North Water  
Wichita, KS 67202

Stafford County. Sec. 31 Twp. 24s Rge. 12 E/W  
Location as "NE/CNW $\frac{1}{4}$ SW $\frac{1}{4}$ " or footage from lines

SE SW SW  
Lease Owner F & M Oil Co., Inc.  
Lease Name Kirkpatrick Well No. 1  
Office Address 422 Union Center, Wichita KS 67202  
Character of Well (Completed as Oil, Gas or Dry Hole)

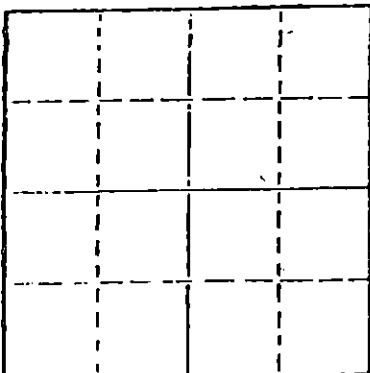

Locate well correctly on above  
Section Plot

Dry Hole  
Date Well completed 2-13 1980  
Application for plugging filed 2-13 1980  
Application for plugging approved 2-13 1980  
Plugging commenced 2-13 1980  
Plugging completed 2-13 1980

Reason for abandonment of well or producing formation  
Dry Hole  
If a producing well is abandoned, date of last production  
\_\_\_\_\_ 19\_\_\_\_

Was permission obtained from the Conservation Division or  
its agents before plugging was commenced? Yes

Name of Conservation Agent who supervised plugging of this well William T. Owen  
Producing formation \_\_\_\_\_ Depth to top \_\_\_\_\_ Bottom \_\_\_\_\_ Total Depth of Well 4210'  
Show depth and thickness of all water, oil and gas formations.

OIL, GAS OR WATER RECORDS

CASING RECORD

FORMATION	CONTENT	FROM	TO	SIZE	PUT IN	PULLED OUT
				8 5/8	326'	None

Describe in detail the manner in which the well was plugged, indicating where the mud fluid  
was placed and the method or methods used in introducing it into the hold. If cement or other  
plugs were used, state the character of same and depth placed, from \_\_\_\_\_ feet to  
\_\_\_\_\_ feet for each plug set.

First plug to 540', 40 sacks Common cement 50/50 Poz Mix with 2% Gel  
Second Plug to 330', 35 sacks  
Third Plug to 40', 10 sacks  
5 sacks in rathole  
Job completed at 2:30 A.M. by Sun Cementing

2-26-80

RECEIVED  
STATE CORPORATION COMMISSION

FEB 26 1980

CONSERVATION DIVISION

(If additional description is necessary, use BACK of this sheet)


Name of Plugging Contractor Allen Drilling Company  
Box 1389, Great Bend, KS 67530

STATE OF Kansas COUNTY OF Barton, ss.  
Allen Drilling Company (employee of owner) or (owner or operator)  
of the above-described well, being first duly sworn on oath, says: That I have knowledge of  
the facts, statements, and matters herein contained and the log of the above-described well  
as filed and that the same are true and correct. So help me God.

(Signature) Ron Danner  
Box 1389, Great Bend, KS 67530  
(Address)

Subscribed and sworn to before me this 22nd day of February, 19 80

Wanda Nichols  
Notary Public.

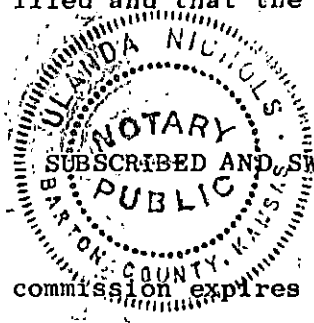

My commission expires 12-10-83