


WELL PLUGGING RECORD

Give All Information Completely
Make Required Affidavit
Mail or Deliver Report to:
Conservation Division
State Corporation Commission
212 No. Market
Wichita, Kansas

NORTH

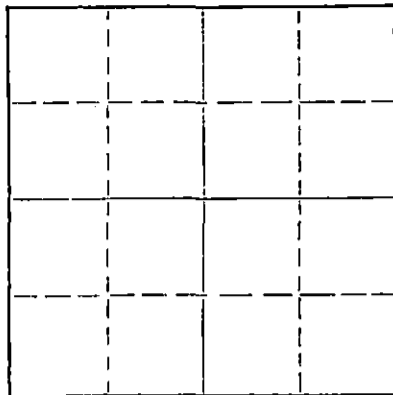

Locate well correctly on above
Section Plat

Stafford County, Sec. 18 Twp. 24 Rge. (E) 13 (W)
Location as "NE/CNWxSWx" or footage from lines NE SW NE
Lease Owner Aylward Drilling Company
Lease Name Rixon Well No. 2
Office Address 909 First National Bank Bldg., Wichita, Kansas 67202
Character of Well (completed as Oil, Gas or Dry Hole) SWDW
Date well completed August 8, 19 61
Application for plugging filed April 26, 19 68
Application for plugging approved April 26, 19 68
Plugging commenced May 4, 19 68
Plugging completed May 8, 19 68
Reason for abandonment of well or producing formation

If a producing well is abandoned, date of last production 19
Was permission obtained from the Conservation Division or its agents before plugging was commenced? Yes

Name of Conservation Agent who supervised plugging of this well R. J. Warren
Producing formation Depth to top Bottom Total Depth of Well 4278 Feet
Show depth and thickness of all water, oil and gas formations.

OIL, GAS OR WATER RECORDS

CASING RECORD

FORMATION	CONTENT	FROM	TO	SIZE	PUT IN	PULLED OUT
				10 3/4"	252'	None
				7"	4183'	2000'

Describe in detail the manner in which the well was plugged, indicating where the mud fluid was placed and the method or methods used in introducing it into the hole. If cement or other plugs were used, state the character of same and depth placed, from feet to feet for each plug set.

Fill hole with rock to 3900' and dump 5 sacks cement
Pumped 35 sacks jell and 100 sacks cement.

RECEIVED
STATE CORPORATION COMMISSION
MAY 23 1968
CONSERVATION DIVISION
Wichita, Kansas

(If additional description is necessary, use BACK of this sheet)

Name of Plugging Contractor Flint Engineering & Construction Company
Address Box 950, El Dorado, Kansas

STATE OF KANSAS, COUNTY OF SEDGWICK, ss.
Duane Jessup (employee of owner) or (owner or operator) of the above-described well, being first duly sworn on oath, says: That I have knowledge of the facts, statements, and matters herein contained and the log of the above-described well as filed and that the same are true and correct. So help me God.

(Signature) Duane Jessup
909 First Nat'l Bank Bldg., Wichita, Kansas
(Address)

SUBSCRIBED AND SWORN TO before me this 23rd day of May, 19 68

My commission expires June 10, 1970

Amy O. Brossette
Notary Public.

RIXON "A" #2

Casing Record:

10 3/4" - 252'
7" - 4183'

Company: Aylward Drilling Company
Contractor: Aylward Drilling Company

Commenced: July 26, 1961
Completed: August 8, 1961

Location: NE SW NE 18-24-13W
Stafford County,
Kansas

Elevation: 1928 D.F. 1931 KB

	<u>From</u>	<u>To</u>	<u>Remarks</u>
Sand	0	160	Set 10 3/4" surface pipe @ 252' w/375 sacks cement.
Blue Shale	160	252	
Shale	252	257	Geological Tops: (Log)
Red Bed & Sand	257	823	
Shale & Lime	823	835	
Shale & Red Bed	835	880	
Anhydrite	880	910	
Shale & Shells	910	1750	
Shale & Lime	1750	2030	
Lime & Shale	2030	2240	
Lime, Shells & Shale	2240	2370	
Lime & Shale	2370	2710	
Shale	2710	2825	
Lime & Shale	2825	3619	
Shale & Lime	3619	3695	
Lime	3695	3760	
Chalky Lime	3760	3800	Heebnar 3448
Lime	3800	3925	Toronto 3446
Lime & Shale	3925	3970	Douglas 3486
Chert	3970	3990	Brown Line 3583
Lime & Chert	3990	4050	Lansing 3614
Lime	4050	4142	Mississippian 3970
Lime & Shale	4142	4255	Viola 4073
Lime	4255	4278 T.D.	Simpson 4120
			Simpson Sand 4135
			Arbuckle 4178 (Sample)
			DST 3971-90 Open 1' 10"
			Rec. 540' gas in pipe, 50' GCM
			All pressures zero.
			DST 3925-4050 Open 1' 10"
			Rec. 30' mud w/few specks oil,
			120' mud.
			FBHP 780#/30" - FBHP 690#/30"
			FP 60#-140#
			DST 4110-4142 Open 1' 10"
			Rec. 450' gas in pipe, 150' hvy.
			O&GCM
			FBHP 1410#/30" - FBHP 1070#/30"
			FP 0# - 0#
			Set 7" casing @ 4183' w/125 sacks.

RECEIVED
STATE CORPORATION COMMISSION
APR 26 1968
CONSERVATION DIVISION
Wichita, Kansas

I hereby certify that this is a true and correct copy of the above log to the best of my knowledge.

Charles D. Williams

Subscribed and sworn to before me this 9th day of August, 1961

Duane Jessup
DUANE JESSUP Notary Public

My commission expires December 11, 1961