


Give Information Completely
Make Required Affidavit
Mail Delivered Report to:
Conservation Division
State Corporation Commission
806 Bittling Building
Wichita, Kansas

WELL PLUGGING RECORD

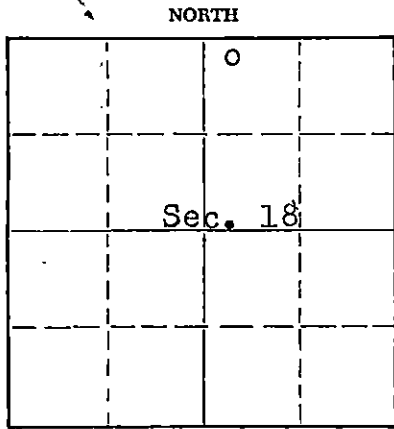

Locate well correctly on above Section Plat

Stafford County. Sec. 18 Twp. 24 Rge. 13 (W) (W)
Location as "NE/CNW/SW" or footage from lines NW-NW-NE
Lease Owner PETROLEUM, INC.
Lease Name RIXON "B" Well No. 1
Office Address ROUTE 2, GREAT BEND, KANSAS
Character of Well (completed as Oil, Gas or Dry Hole) Dry Hole
Date well completed August 26 19 56
Application for plugging filed August 28 19 56
Application for plugging approved August 26 19 56
Plugging commenced August 26 19 56
Plugging completed August 26 19 56
Reason for abandonment of well or producing formation No Producing Zones

If a producing well is abandoned, date of last production None 19
Was permission obtained from the Conservation Division or its agents before plugging was commenced? Yes

Name of Conservation Agent who supervised plugging of this well R.M. Brundege Hoisington, Kansas
Producing formation --- Depth to top --- Bottom --- Total Depth of Well 4080 Feet
Show depth and thickness of all water, oil and gas formations.

OIL, GAS OR WATER RECORDS

CASING RECORD

FORMATION	CONTENT	FROM	TO	SIZE	PUT IN	PULLED OUT
				8 5/8" OD	207'	None

Describe in detail the manner in which the well was plugged, indicating where the mud fluid was placed and the method or methods used in introducing it into the hole. If cement or other plugs were used, state the character of same and depth placed, from feet to feet for each plug set.

Mud up with heavy mud to 180' pushed down 1/2 sacks hulls to 180' followed by wooden plug. Placed 20 sacks cement through drill pipe on to plug. Mud up to 35' and placed 1/2 sacks hulls at 35' followed by wooden plug and 10 sacks cement to base of well cellar.

(If additional description is necessary, use BACK of this sheet)

Name of Plugging Contractor Garvey Drilling Co.
Address Route 2, Great Bend, Kansas

STATE OF KANSAS, COUNTY OF BARTON, ss.
DON SEARLE (employee of owner) or (owner/operator) of the above-described well, being first duly sworn on oath, says: That I have knowledge of the facts, statements, and matters herein contained and the log of the above-described well as filed and that the same are true and correct. So help me God.

(Signature) Don Searle
Route 2, Great Bend, Kansas
(Address)

SUBSCRIBED AND SWORN TO before me this 31st day of AUGUST, 19 56

My commission expires July 11, 1960

Led L. Brown
STATE CORP.
Notary Public.

PLUGGING
FILE SEC. 18T 24R 13W
BOOK PAGE 93 LINE 26

CONSERVATION DIVISION
Wichita, Kansas

9-4-56

WELL LOG

15-185-00317-0000

COMPANY PETROLEUM, INCORPORATED

SEC. 18 T. 24S R. 13W

FARM Rixon 'B' #1

NO. 1

LOC. NW, NW, NE

TOTAL DEPTH 4080'

COUNTY Stafford Co., Kansas

COMM. August 15, 1956

COMP. August 26, 1956

CONTRACTOR GARVEY DRILLING COMPANY



CASING 8 5/8" @ 207' W/200 sax.

ELEVATION 1928' DF

PRODUCTION D & A

FIGURES INDICATE BOTTOM OF FORMATIONS

207	Sand & blue shale	Anhydrite	815'
815	Red bed	Heebner	3426'
850	Anhydrite	Toronto	3445'
1800	Shale	Douglas	3464'
2150	Lime & shale	Brown Lime	3561'
2300	Lime	Lansing	3594'
3454	Lime & shale		
3843	Lime		
3885	Lime & chert		
3930	Lime		
3952	Lime & chert		
3992	Shale & chert		
4019	Lime, shale & chert		
4056	Lime & chert		
4080	Chert		
4080	T. D.		

PLUGGING
 FILE SEC 18 T. 24 R. 13W
 BOOK PAGE 93 LINE 26

RECEIVED
STATE CORPORATION COMMISSION

State of KANSAS
 County of BARTON

I, Verne A. Morris of Garvey Drilling Company

upon oath state that the above and foregoing is a true and correct copy of the log of the #1 Rixon 'B' well

Verne A. Morris

Subscribed and sworn to before me this 30th day of August 19 56

My Commission Expires: July 11, 1960

Jed L. Beson
NOTARY PUBLIC