

WELL PLUGGING RECORD

Give All Information Completely
Make Required Affidavit
Mail or Deliver Report to:
Conservation Division
State Corporation Commission
211 No. Broadway
Wichita, Kansas

Stafford County, Sec. 18 Twp. 24 Rge. (E) 13(W)

Location as "NE/CNW/SE/SW" or footage from lines NW NW SW

Lease Owner: Natural Gas and Oil Company

Lease Name: P.O. McConaughay Well No. 2

Office Address: P.O. Box 1150, Great Bend, Kansas

Character of Well (completed as Oil, Gas or Dry Hole): Gas

Date well completed: July 21 19 60

Application for plugging filed: February 26 19 65

Application for plugging approved: March 1 19 65


Plugging commenced: March 23 19 65

Plugging completed: March 30 19 65

Reason for abandonment of well or producing formation: Depleted

If a producing well is abandoned, date of last production: November 30 19 64

Was permission obtained from the Conservation Division or its agents before plugging was commenced? yes

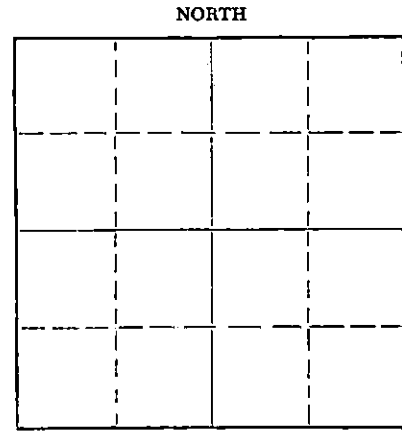

Locate well correctly on above Section Plat

Name of Conservation Agent who supervised plugging of this well: A. Elving

Producing formation: Mississippi Depth to top: 3908 Bottom: 3919 Total Depth of Well: 3975 Feet

Show depth and thickness of all water, oil and gas formations.

OIL, GAS OR WATER RECORDS

CASING RECORD

FORMATION	CONTENT	FROM	TO	SIZE	PUT IN	PULLED OUT
				8 5/8"	235	None
				2 7/8"	3973	3492

Describe in detail the manner in which the well was plugged, indicating where the mud fluid was placed and the method or methods used in introducing it into the hole. If cement or other plugs were used, state the character of same and depth placed, from _____ feet to _____ feet for each plug set.

Plug at 3826 with 15 sacks cement
Plug well with 10 sacks gel and 70 sacks cement at 250 lbs.
Cap surface pipe with 5 sacks cement

RECEIVED
STATE CORPORATION COMMISSION

APR 1 1965

CONSERVATION DIVISION
Wichita, Kansas

(If additional description is necessary, use BACK of this sheet)

Name of Plugging Contractor: Knight Casing Pulling Company

Address: Chase, Kansas

STATE OF KANSAS, COUNTY OF BARTON, ss.
I, J. B. Steele, Jr. (employee of owner) or (owner or operator) of the above-described

well, being first duly sworn on oath, says: That I have knowledge of the facts, statements, and matters herein contained and the log of the above-described well as filed and that the same are true and correct. So help me God.

(Signature) *J. B. Steele, Jr.*

P.O. Box 1150, Great Bend, Kansas
(Address)

SUBSCRIBED AND SWORN TO before me this 31st day of March, 19 65

Richard R. Beach
Notary Public.

My commission expires July 27, 1967



DRILLERS LOG

#2 McConnaughay

CASING RECORD: 227.73' of 8-5/8" surface casing
 COMPANY: Natural Gas & Oil Co.
 DESCRIPTION: NW NW SW Section 18-24S-13W Stafford County, Kansas
 CONTRACTOR: Strata Drilling, Inc.
 TOTAL DEPTH: 3975'
 COMMENCED: July 5, 1960
 ELEVATION: 1931' DF
 COMPLETED: July 13, 1960

FORMATION	FROM	TO	REMARKS
Sand	0	100	Ran 227.73' of 8-5/8" new surface casing; set and cemented at 235.23' with 220 sacks of regular cement, 3% gel and 2% C. C. Plug down at 8:00 P. M. 7-5-1960.
Blue Shale	100	140	
Shale	140	237	
Red Bed & Shale	237	825	
Anhydrite	825	860	
Shale & Shells	860	1675	
Shale & Lime	1675	1810	
Lime	1810	1985	
Lime with Shale Streaks	1985	2215	
Lime & Shale	2215	3355	
Lime	3355	3453	DST #1 3658'-3668' tool open 1 hour, good blow. Recovered 15' oil cut mud, 350' salt water. INIF 920 lbs. IFP 50 lbs. FFP 185 lbs. BHP 670 lbs. in 20 minutes.
Lime & Shale	3453	3553	
Lime	3553	3864	
Lime & Chert	3864	3975	DST #2 3710'-3740' tool open 1 hour, good blow. Recovered 1230' gas, 30' gassy mud. IFP 40 lbs. FFP 40 lbs. BHP 160 lbs. in 20 minutes.
Total Depth 3975'			DST #3 3897'-3935' tool open 1 hour, gas in 5 minutes 520,000, 80' gassy mud. IBHP 1175 lbs. IFP 110 lbs. FFP 160 lbs. FBHP 1230 lbs. in 20 minutes.

RECEIVED
 STATE CORPORATION COMMISSION

MAR 1 1965
 3-1-65
 CONSERVATION DIVISION
 Wichita, Kansas

Ran 3965' of 2 1/2" tubing; set and cemented at 3973' with 125 sacks of regular cement. Plug down @ 11:15 P. M. 7-13-1960.

STATE OF KANSAS)
) ss.
 COUNTY OF BARTON)

I certify that this is a true and correct copy of the above log to the best of my knowledge.

STRATA DRILLING, INC.

Charles W. Steincamp
 Charles W. Steincamp, President

Subscribed and sworn to before me this 14th day of July, 1960.

Elaine H. Taylor
 Elaine H. Taylor, Notary Public

My Commission Expires:

December 14, 1961

JUL 15 1960