

9

STATE OF KANSAS
STATE CORPORATION COMMISSION

WELL PLUGGING RECORD

Give all information Completely
Make Required Affidavit
Mail or Deliver Report to:
Conservation Division
State Corporation Commission
212 No. Market
Wichita, Kansas

Stafford County. Sec. 18 Twp. 24 Rge. 13 (E) (W)

Location as "NE/CNW/SW" or footage from lines NE NE SW

Lease Owner Great Bend Pipe & Supply

Lease Name McConnoughay Well No. 3

Office Address Great Bend, Kansas

Character of Well (completed as Oil, Gas or Dry Hole)

Date well completed 19

Application for plugging filed 19

Application for plugging approved 19


Plugging commenced 8/15/67 19

Plugging completed 8/23/67 19

Reason for abandonment of well or producing formation depleted.

If a producing well is abandoned, date of last production 19

Was permission obtained from the Conservation Division or its agents before plugging was commenced? yes

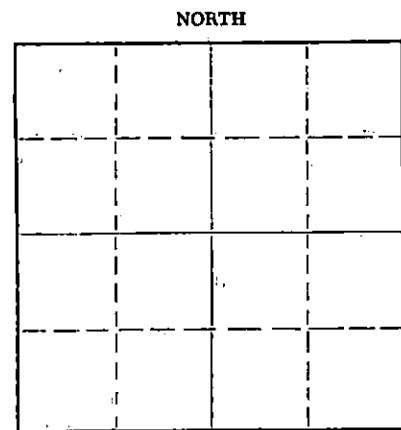

Name of Conservation Agent who supervised plugging of this well Elving

Producing formation Depth to top Bottom Total Depth of Well 4159 Feet

Show depth and thickness of all water, oil and gas formations.

OIL, GAS OR WATER RECORDS

CASING RECORD

FORMATION	CONTENT	FROM	TO	SIZE	PUT IN	PULLED OUT
				8-5/8	220	none
				5-1/2	4156	3265'

Describe in detail the manner in which the well was plugged, indicating where the mud fluid was placed and the method or methods used in introducing it into the hole. If cement or other plugs were used, state the character of same and depth placed, from feet to feet for each plug set.

Checked hole to 4159', sanded to 4100' and ran 5 sacks of cement. Loaded hole with water, shot pipe at 3575', pumped 4 sacks of mud and 2 sacks of hulls. Shot pipe at 3513'. Had plug in hole, pushed plug to 3350'. Shot pipe at 3315', pumped 40 bbls. oil. Checked plug at 2825', pumped load of water, shot pipe at 3251', worked pipe loose. Pumped 10 sacks mud and 80 sacks cement. Tallied pipe,

PLUGGING COMPLETE.

RECEIVED
STATE CORPORATION COMMISSION
AUG 29 1967

CONSERVATION DIVISION
Wichita, Kansas

Name of Plugging Contractor KNIGHT CASING PULLING COMPANY
Address CHASE, KANSAS

STATE OF KANSAS, COUNTY OF RICE, ss.
NOEL J. KNIGHT (employee of owner) or (owner or operator) of the above-described well, being first duly sworn on oath, says: That I have knowledge of the facts, statements, and matters herein contained and the log of the above-described well as filed and that the same are true and correct. So help me God.

(Signature) *Noel Knight*
CHASE, KANSAS
(Address)

SUBSCRIBED AND SWORN TO before me this 25th day of August, 1967

My commission expires February 15, 1971

Margaret Mulcher
Notary Public.

R

DRILLERS LOG

#3 McConaughay

CASING RECORD: 220.80' new 8-5/8" Surface Casing
 COMPANY: Natural Gas & Oil Co.
 DESCRIPTION: NE NE SW Section 18-24S-13W Stafford County, Kansas
 CONTRACTOR: Strata Drilling, Inc.
 TOTAL DEPTH: 4150'
 COMMENCED: October 6, 1960
 COMPLETED: October 15, 1960

FORMATION	FROM	TO	REMARKS
Surface Clay & Sand	0	145	Ran 220.80' (7 Jts.) of new 8-5/8" surface casing; set and cemented at 227.80' with 225 sacks of cement. Plug down @ 11:30 P. M. 10-6-1960.
Shale	145	230	
Red Bed & Shale	230	813	
Anhydrite	813	832	
Shale	832	1040	
Shale & Shells	1040	1680	
Shale & Lime	1680	1780	
Lime w/Shale	1780	1980	
Lime & Shale	1980	3769	
Lime	3769	3958	
Chert & Lime	3958	4000	
Lime & Shale	4000	4024	
Shale (Kinderhook)	4024	4062	
Cherty Lime	4062	4085	
Chert, Shale & Sand	4085	4150	

Total Depth 4150'

RECEIVED
 STATE CORPORATION COMMISSION

JUL 25 1967

CONSERVATION DIVISION
 Wichita, Kansas

Ran 4159.43' (129 Jts.) of 5 1/2" casing; set and cemented at 4155' with 100 sacks of regular cement. Plug down @ 10:00 A. M. 10-15-1960.

STATE OF KANSAS)
 COUNTY OF BARTON) ss.

I certify that this is a true and correct copy of the above log to the best of my knowledge.

STRATA DRILLING, INC.

Charles W. Steincamp
 Charles W. Steincamp, President

Subscribed and sworn to before me this 17th day of October, 1960.

Elaine N. Taylor
 Elaine N. Taylor, Notary Public

My Commission Expires:
 December 14, 1961

