


STATE OF KANSAS  
STATE CORPORATION COMMISSION

WELL PLUGGING RECORD

Give All Information Completely  
Make Required Affidavit  
Mail or Deliver Report to:  
Conservation Division  
State Corporation Commission  
800 Bittling Building  
Wichita, Kansas

Kingman County, Sec. 1 Twp. 30S Rge. 9W (W)  
Location as "NE/CNW/SW" or footage from lines 660' from N, 660' from W, NW/4  
Lease Owner Phillips Petroleum Company  
Lease Name Griem "A" Well No. 1  
Office Address Box 779, Great Bend, Kansas  
Character of Well (completed as Oil, Gas or Dry Hole) Dry Hole  
Date well completed April 21, 19 56  
Application for plugging filed April 23, 19 56  
Application for plugging approved April 23, 19 56  
Plugging commenced April 21, 19 56  
Plugging completed April 21, 19 56  
Reason for abandonment of well or producing formation Dry Hole

NORTH

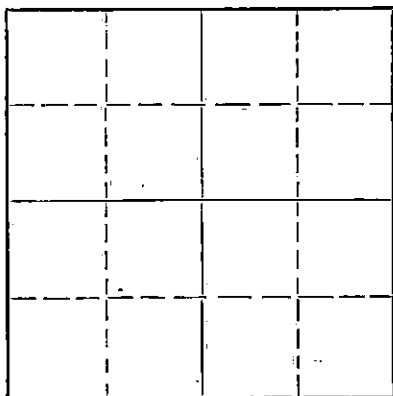

Locate well correctly on above  
Section Plat

If a producing well is abandoned, date of last production - 19 -  
Was permission obtained from the Conservation Division or its agents before plugging was commenced? Yes.

Name of Conservation Agent who supervised plugging of this well Mr. M. A. Rives  
Producing formation Dry Hole Depth to top \_\_\_\_\_ Bottom \_\_\_\_\_ Total Depth of Well 4265 Feet  
Show depth and thickness of all water, oil and gas formations.

OIL, GAS OR WATER RECORDS

CASING RECORD

FORMATION	CONTENT	FROM	TO	SIZE	PUT IN	PULLED OUT
Heebner	Dry	3258	3273	8-5/8"	219 OA	None
Toronto	Dry	3273	3302			
Douglas	Dry	3302	3476			
Lansing-Kansas City	Dry	3476	3945			
Marmaton	Dry	3961	4172			
Mississippian	Dry	4172	4265			

Describe in detail the manner in which the well was plugged, indicating where the mud fluid was placed and the method or methods used in introducing it into the hole. If cement or other plugs were used, state the character of same and depth placed, from \_\_\_\_\_ feet to \_\_\_\_\_ feet for each plug set.

Mudded hole from 4265' to 280'. Set Halliburton Wood plug and 1/3 sack hulls at 280'. Dumped 20 sx. cement in filling to 220'. Mudded hole to 35'. Set wood plug and 1/3 sack hulls at 35'. Dumped 10 sx. cement in filling to base of cellar. Well Plugged and Abandoned at 2:00 P.M. 4-21-56.

RECEIVED  
STATE CORPORATION COMMISSION

APR 27 1956

CONSERVATION DIVISION  
Wichita, Kansas

4-27-56

(If additional description is necessary, use BACK of this sheet)

Name of Plugging Contractor Garvey Drilling Company  
Address R.R. #2 - Great Bend, Kansas

STATE OF Kansas, COUNTY OF Barton, ss.

A. J. Willis (employee of owner) ~~not a sworn operator~~ of the above-described well, being first duly sworn on oath, says: That I have knowledge of the facts, statements, and matters herein contained and the log of the above-described well as filed and that the same are true and correct. So help me God.

(Signature) \_\_\_\_\_

Box 779, Great Bend, Kansas  
(Address)

SUBSCRIBED AND SWORN TO before me this 26th day of April, 19 56

My commission expires November 18, 1957

Joseph M. Deal  
Notary Public.

PLUGGING  
FILE SEC LT 30 9W  
BOOK PAGE 56 LINE 2

EXPLORATION RECORD

PHILLIPS PETROLEUM COMPANY

Griem "A" #1 - 660' from North and 660' from West lines,  
NW/4 Sec. 1-30S-9W, Kingman County, Kansas

Lease Griem #1

Well 1

Formation Name	Top	Base	Remarks
Sand and redbed	0	316	
Redbed	316	420	
Redbed and shale	420	715	
Shale and shalle	715	1320	
Lime and chole	1320	1775	
Lime	1775	2085	
Lime and shale	2085	3302	
Shale and sand	3302	3360	
Sand	3360	3476	
Lime and shale	3476	3571	
Lime	3571	4065	
Lime and shale	4065	4150	
Chert	4150	4182	*Drill Stem Test
Lime	4182	4200	*Drill Stem Test
Chert	4200	4248	
Lime	4248	**4265	
			*See Daily Report Detailed.
			**Not penetrated at 4265' TD.
<u>FORMATION TOPS (SAMPLE)</u>			
Heebner	3258		
Toronto	3273		
Douglas	3302		
Lanning-Kansas City	3476		
Base-Kansas City	3945		
Maraton	3961		
Mississippian	4172		
Rotary Total Depth	4265		
DRY HOLE - Well Plugged and abandoned 4-21-56.			

RECEIVED  
STATE CORPORATION COMMISSION

APR 27 1956

CONSERVATION DIVISION  
Wichita, Kansas

**PLUGGING**  
FILE SEC 1 T 30 R 9W  
BOOK PAGE 56 LINE 8