


STATE OF KANSAS
STATE CORPORATION COMMISSION
Give All Information Completely
Make Required Affidavit
Mail or Deliver Report to:
Conservation Division
State Corporation Commission
211 No. Broadway
Wichita, Kansas

WELL PLUGGING RECORD

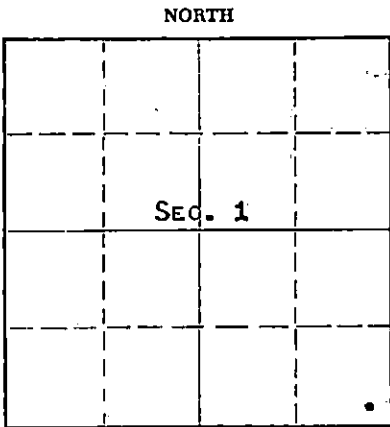

KINGMAN County. Sec. 1 Twp. 30s Rge. 9W (E) X(W)
Location as "NE/CNWxSWx" or footage from lines APPROX. SE SE SE
Lease Owner PETROLEUM, INC.
Lease Name ZRUBEK Well No. 1
Office Address ROUTE 2, GREAT BEND, KANSAS
Character of Well (completed as Oil, Gas or Dry Hole) DRY HOLE
Date well completed MAY 27, 1963
Application for plugging filed MAY 27, 1963
Application for plugging approved MAY 27, 1963
Plugging commenced MAY 27, 1963
Plugging completed MAY 27, 1963
Reason for abandonment of well or producing formation NO PRODUCIBLE FORMATIONS
If a producing well is abandoned, date of last production NONE 19
Was permission obtained from the Conservation Division or its agents before plugging was commenced? YES

Name of Conservation Agent who supervised plugging of this well ARCHIE ELVING
Producing formation --- Depth to top --- Bottom --- Total Depth of Well 4284 Feet
Show depth and thickness of all water, oil and gas formations.

OIL, GAS OR WATER RECORDS

CASING RECORD

FORMATION	CONTENT	FROM	TO	SIZE	PUT IN	PULLED OUT
				8-5/8"	258	NONE

Describe in detail the manner in which the well was plugged, indicating where the mud fluid was placed and the method or methods used in introducing it into the hole. If cement or other plugs were used, state the character of same and depth placed, from --- feet to --- feet for each plug set.

MUDDED UP WITH HEAVY MUD TO 240' FOLLOWED BY WOODEN PLUG AND 1/4 SACK HULLS. PLACED 20 SACKS CEMENT THROUGH DRILL PIPE ONTO HULLS. MUDDED UP WITH HEAVY MUD TO 40', FOLLOWED BY WOODEN PLUG, 1/4 SACK HULLS AND 8 SACKS CEMENT TO BASE OF WELL CELLAR. PLACED 2 SACKS CEMENT IN RAT HOLE.

RECEIVED
STATE CORPORATION COMMISSION

JUN 10 1963
6-10-63

CONSERVATION DIVISION
Wichita, Kansas

(If additional description is necessary, use BACK of this sheet)
Name of Plugging Contractor GARVEY DRILLING COMPANY
Address ROUTE 2, GREAT BEND, KANSAS

STATE OF KANSAS, COUNTY OF BARTON, ss.

DON SEARLE (employee of owner) or (owner) of the above-described well, being first duly sworn on oath, says: That I have knowledge of the facts, statements, and matters herein contained and the log of the above-described well as filed and that the same are true and correct. So help me God. DON SEARLE, DIST. PROD. SUPT.

(Signature) *Don Searle*
ROUTE 2, GREAT BEND, KANSAS
(Address)

SUBSCRIBED AND SWORN to before me this 6TH day of JUNE, 1963

My commission expires APRIL 14, 1967 *Arthur J. Miles* Notary Public.

WELL LOG ¹⁵⁻⁰⁹⁵⁻⁰¹⁵¹³⁻⁰⁰⁰⁰

COMPANY Petroleum Inc.

SEC. 1 T. 30S R. 9W

FARM Zrubek NO. #1


LOC. SE SE

TOTAL DEPTH 4284'

COUNTY Kingman

COMM. 5-17-63 COMP. 5-27-63

CONTRACTOR Garvey Drilling Company

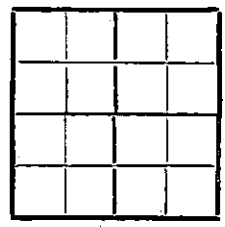

CASING 8 5/8" @ 258' w/225 sx

ELEVATION 1582' DF

PRODUCTION D & A

FIGURES INDICATE BOTTOM OF FORMATIONS

- 25' Sand
- 258' Red Bed
- 1310' Shale and Shells
- 1570' Lime and Shale
- 1960' Lime
- 3535' Lime and Shale
- 4284' Lime
- 4284' RTD

RECEIVED
 STATE CORPORATION COMMISSION
 JUN 10 1963
 CONSERVATION DIVISION
 Wichita, Kansas

State of Kansas
 County of Kingman } ss

I, Sam N. Stephens of Garvey Drilling Company

upon oath state the above and foregoing is a true and correct copy of the log of the Zrubek #1 well.

Sam N. Stephens

Subscribed and sworn to before me this 5th day of June 19 63

My Commission Expires: April 14th, 1967

Arthur J. Wile
 NOTARY PUBLIC